

# COPPER SKY DESTILLERY UNITS C, D, E 110 Emery Street Longmont, CO 80501

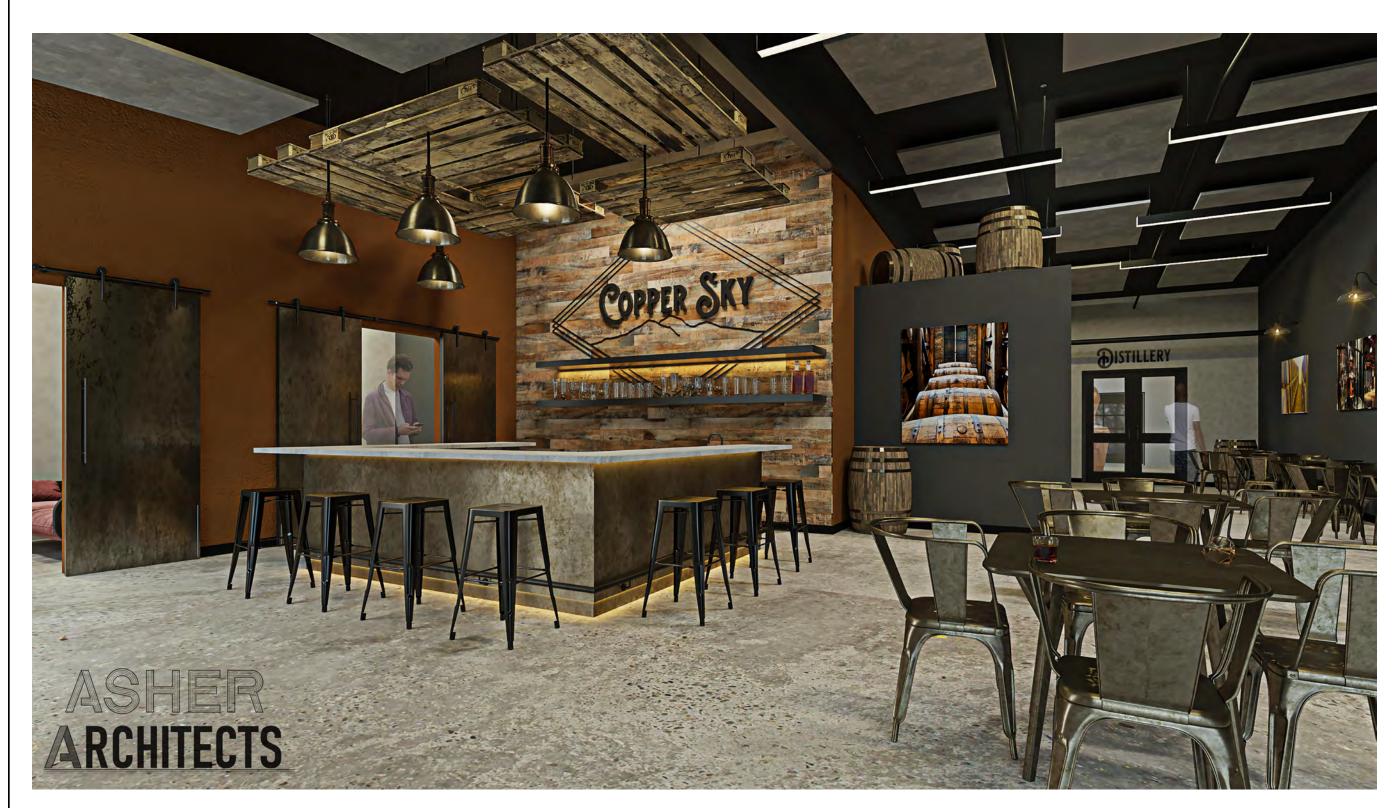

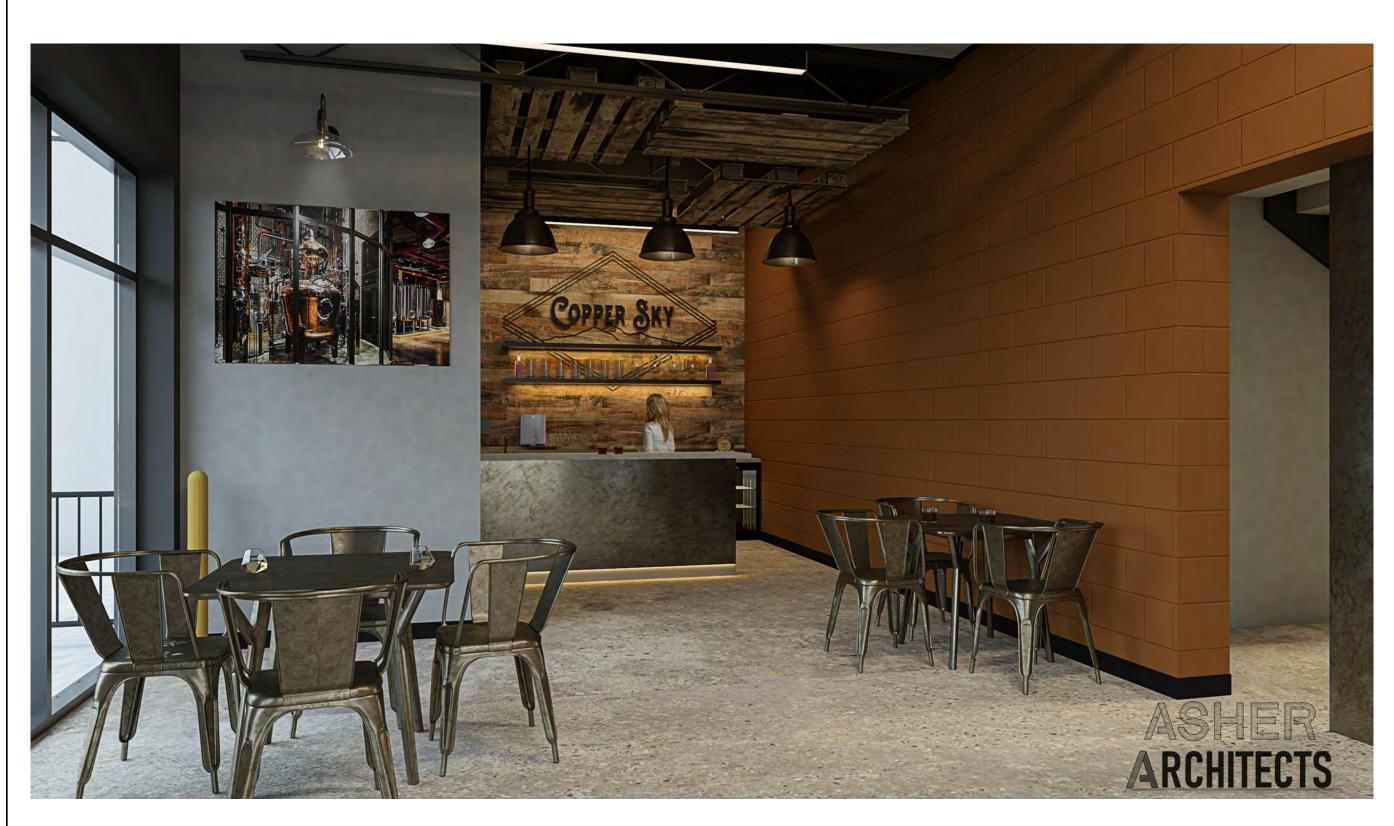

# PROJECT NARRATIVE:

The owner of Copper Sky Distillery is proposing to relocate his existing business operation to the existing core and shell structure located at 110 Emery Street in Longmont, CO. Copper Sky Distillery will occupy units C, D, and E, within the building with a total tenant space of 6,905 s.f. The business operation includes a tasting room and bar along the north side of the building for customers to enjoy the distilled spirits. The tasting room includes a small retail area, a men's restroom and vomens restroom. A large storage room is adjacent to the tasting room for storage of dry goods such as glass bottles, dustles grain, and sugar. No high pile storage is roposed. Beyond the tasting room is the processing room where the still and related distillery equipment is located. Adjacent to the processing room is a break room, nezzanine office. and the barrel storage room where wood casks of distilled spirits will be stored. Beyond the processing room is a private tasting room for tour groups to taste distilled spirits. This bar will only be available to tour guests by appointment and will have a very minimal occupant load. One shared restroom is available adjacent to the private bar area.

The thermal envelope of the structure was analyzed during the core and shell permit review. One new exterior man door is proposed and one new overhead door. Each door will be insulated.

# **SHEET INDEX**

SHEET NO	SHEET NAME					
ARCHITECTURAL						
A0.0	COVER SHEET					
A0.1	EGRESS STUDY					
A0.2	DATA					
A1.0	EXISTING CONDITION/ DEMO					
A1.1	PROPOSED OVERALL PLAN					
A1.2	ROOF PLAN					
A1.3	DETAIL PROD/ STORAGE PLAN					
A1.4	DETAIL TASTING BAR					
A1.5	DETAIL SPEAK EASY BAR					
A1.6	FURNITURE DETAIL					
A1.7	OFFICE/ MEZZANINE DETAIL					
A3.0	SECTIONS					
A5.0	BOILER ROOM DETAILS					
A5.1	ADA RESTROOMS / RCP DETAILS					
A5.2	STAIR/ HIDDEN DOOR DETAILS/ SPEC SHEETS					
A5.3	DETAILS/ SPEC SHEETS					
STRUCTURAL						
S1.0	GENERAL NOTES, ABREVIATIONS, SYMBOLS & DETAILS					
S2.0	FOUNDATION PLAN					
S2.1	MEZZANINE AND LOW ROOF FRAMING PLAN					
S2.2	UPPER ROOF FRAMING PLAN					
S3.0	DETAILS					
S3.1	DETAILS					
MECHANICAL						
M1.0	SCHEDULES					
M1.1	MEC PLAN					
ELECTRICAL						
E0.0	NOTES & ONE-LINE DIAGRAM					
E0.1	SCHEDULES					
E1.0	LIGHTING PLAN					
E2.0	POWER PLAN					
PLUMBING	·					
P0.1	DETAILS & SCHEDULES					
P1.0	WASTE AND VENT PIPING					
P2.0	WATER AND GAS PIPING					
SUPPLEMENTAL DO	CUMENTS					
F	FIRE REPORT					

Name	Number	Level	Area		
	1141111501		71.00		
TASTING/BAR	101	T.O. SLAB	1630 SF		
DRY STORAGE	102	T.O. SLAB	781 SF		
M/RR	103	T.O. SLAB	65 SF		
W/RR	104	T.O. SLAB	65 SF		
UTL	105	T.O. SLAB	23 SF		
PRODUCTION	106	T.O. SLAB	1544 SF		
BARREL STORAGE	107	T.O. SLAB	1195 SF		
BREAK ROOM	108	T.O. SLAB	204 SF		
SHARED RR	109	T.O. SLAB	94 SF		
SPEAK EASY BAR	110	T.O. SLAB	894 SF		
RETAIL	111	T.O. SLAB	100 SF		
BOILER ROOM	112	T.O. SLAB	108 SF		
T.O. SLAB: 12		•	6701 SF		
OFFICE	201	T.O. MEZZANINE	204 SF		
T.O. MEZZANINE: 1			204 SF		
Grand total: 13			6905 SF		
OUTDOOR PATIO	113	T.O. SLAB	467 SF		
T.O. SLAB: 1			467 SF		
Grand total: 1			467 SF		

NOTE: THE ROOM AREAS ABOVE EXCLUDE WALL THICKNESS.

### PROJECT DIRECTORY

#### **OWNER:** Mike Root

1115 Colorado Ave, Suite C. Longmont, CO 80501

**Contact: Mike Root** mike@copperskydistillery.com

### ARCHITECT: **Asher Architects**

512 5th Street Berthoud, CO 80513 **Contact: David Stranathan** (970) 532-9970

david@asherarch.com

### STRUCTURAL ENGINEER: G.A. ESCOBAR ASSOCIATES

**402 Main Street** Longmont, CO 80501 **Contact: Gus Escobar** (303) 678-5222

Gus@gaescobar.com

# **MECHANICAL EGINEER:**

**Denver Heating & Air** 1900 W HAmilton Place Sheridan, Colorado 80110 (720) 626-3487

# **ELECTRICAL ENGINEER:**

**Bret's Electric, LLC** 

duane@denverheating.com

8312 Raspberry Way, Suite A Frederick, Colorado 80504 **Contact: Justin Martin** (720) 494-8944

ustin@bretselectric.com

# **PLUMBING ENGINEER:**

# **Thompson Engineering**

1615 California Street, Suite 301 Denver, Colorado 80202 **Contact: Josh Brooks** (303) 991-0991 X204 jbrooks@thompson-eng.com

# FIRE ENGINEER:

**Veritas Fire Engineering** 12364 W. Alameda Pkwy, Suite 135

Lakewood, Colorado 80228 Contact: Kenneth Sutton (303) 985-3300 email@veritasfire.com

# **GENERAL CONTRACTOR:**

318 Main Street Longmont, CO 80501 **Contact: Steven South** (303) 264-8561

steven@lsebuildersgroup.com

**LSE Builders Group** 

### **AREA SCHEDULE - BY LEVEL LEVEL AREA** NAME T.O. SLAB T.O. MEZZANINE 7013 SF Grand total: 2

### **GENERAL NOTES**

1. THE TERM "OWNER" SHALL DENOTE THE CLIENT. OR OWNER, AS DESIGNATED IN THE CONTRACT. THE TERM "GENERAL CONTRACTOR" OR "CONTRACTOR" SHALL DENOTE THE CORPORATION, COMPANY, PARTNERSHIP, FORM OR INDIVIDUAL WHO HAS ENTERED INTO THE CONTRACT FOR THE PERFORMANCE OF THE WORK AND HAS ENGAGED SUBCONTRACTORS TO PERFORM A PART OF THE WORK. THE TERM "DESIGNER" REFERS TO ASHER

2.THE USE OF THE WORDS "PROVIDE" AND "PROVIDED" IN CONNECTION WITH ANY ITEM SPECIFIED SHALL BE INTENDED TO MEAN THAT THE ITEM SHALL BE FURNISHED, INSTALLED AND CONNECTED WHERE SO REQUIRED.

3.ALL DIMENSIONS ARE TAKEN TO FACE OF STUD, GRID CENTERLINES, OR FACE OF MASONRY UNLESS OTHERWISE NOTED.

4.DO NOT SCALE DRAWINGS. DIMENSIONS GOVERN. LARGE SCALE DETAILS GOVERN OVER SMALL SCALE

5.THE DRAWINGS AND SPECIFICATIONS ARE SUPPLIED TO ILLUSTRATE THE DESIGN INTENT AND THE GENERAL TYPE OF CONSTRUCTION REQUIRED. THEY ARE INTENDED TO IMPLY THE FINEST QUALITY OF CONSTRUCTION, MATERIAL AND WORKMANSHIP

6.DRAWINGS AND GENERAL NOTES ARE COMPLEMENTARY, AND WHAT IS CALLED FOR BY ONE WILL BE BINDING AS IF CALLED FOR BY ALL. WORK SHOWN OR REFERRED TO ON ANY DRAWING SHALL BE COMPLETED AS THOUGH SHOWN ON ALL RELATED

7 ALL WORK PERFORMED AND MATERIAL INSTALLED SHALL BE, AS A MINIMUM STANDARD, IN STRICT CONFORMANCE WITH THE LATEST EDITIONS OF ALI GENERAL CODES, REGULATIONS AND ORDINANCES INCLUDING THE BUILDING CODE. THE CONTRACTOR SHALL GIVE ALL NOTICES AND COMPLY WITH ALL LAWS, ORDINANCES, RULES, REGULATIONS AND LAWFUL ORDERS OF ANY PUBLIC AUTHORITY HAVING

NOTED, SPECIFIED, OR REASONABLY INFERRED FROM THE CONSTRUCTION DOCUMENTS.

JURISDICTION OVER THE PERFORMANCE OF THE WORK

9.THE GENERAL CONTRACTOR UPON ACCEPTANCE OF THE DRAWINGS AND SPECIFICATIONS ASSUMES FULL RESPONSIBILITY FOR THE CONSTRUCTION, MATERIALS AND WORKMANSHIP OF THE WORK, AND SHALL COMPLY WITH THE SPIRIT AS WELL AS THE LETTER OF THAT WHICH IS CONTAINED THEREIN.

10.THE SCOPE OF WORK DESCRIBED BY THE CONTRACT DOCUMENTS IMPLIES A COMPLETED PROJECT. MINOR OMISSIONS FROM AND DISCREPANCIES IN THE DRAWINGS AND SPECIFICATIONS SHALL NOT VOID SUCH INTENTION. THE CONTRACTOR SHALL INFORM THE DESIGNER IN WRITING OF ANY CONFLICTS, OMISSIONS AND DISCREPANCIES PRIOR TO CONSTRUCTION.

11.THE GENERAL CONTRACTOR SHALL SUPERVISE AND DIRECT THE WORK USING HIS BEST SKILL AND ATTENTION. HE SHALL BE SOLELY RESPONSIBLE FOR ALL CONSTRUCTION MEANS, METHODS, TECHNIQUES, SEQUENCES AND PROCEDURES. HE SHALL COORDINATE ALL PORTIONS OF THE WORK UNDER THE CONTRACT.

> 12.THE GENERAL CONTRACTOR SHALL PERFORM HIGH-QUALITY PROFESSIONAL WORK. MATERIALS SHALL BE JOINED TO UNIFORM, ACCURATE FITS SO THAT THEY MEET IN NEAT, STRAIGHT LINES FREE OF SMEARS OR OVERLAPS. EXPOSED MATERIALS SHALL BE INSTALLED APPROPRIATELY LEVEL, PLUMB AND AT ACCURATE RIGHT ANGLES TO OR FLUSH WITH ADJACENT MATERIALS. THE WORK OF EACH TRADE SHALL MEET ALL NATIONAL STANDARDS PUBLISHED BY THE TRADE, EXCEPT WHERE THE REQUIREMENTS OF THE CONTACT DOCUMENT ARE MORE STRINGENT.


13. THE PRESENCE OF AN ARCHITECTURAL REPRESENTATIVE ON THE JOBSITE DOES NOT IMPLY CONCURRENCE OF APPROVAL OF THE WORK. THE CONTRACTOR SHALL CALL TO THE ATTENTION OF THE DESIGNER SPECIFIC ITEMS FOR WHICH HE DESIRES TO OBTAIN APPROVAL.

14. THE GENERAL CONTRACTOR SHALL CORRECT DEFECTS IN MATERIAL AND WORKMANSHIP NOTED BY THE DESIGNER DURING PERIODIC SITE OBSERVATIONS AND AT PROJECT CLOSE-OUT.

PROJECT OVER TO THE OWNER FREE FROM ALL CONSTRUCTION DEBRIS, SCRAPS, MATERIALS AND EQUIPMENT; WITH ALL INTERIOR GLASS FREE FROM MANUFACTURER'S LABELS AND TAPE AND CLEAN ON BOTH SIDES; WITH ALL DOORS AND BUILT-IN MILLWORK WIPED DOWN AND FREE OF DIRT, GREASE AND OTHER FOREIGN MATERIAL.




110 EMERY STREET Longmont, Co 80501 **Boulder County, Colorado** 

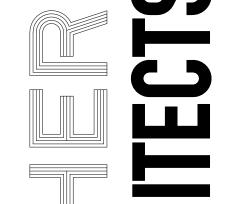

© ASHER ARCHITECTS B.CORP ALL RIGHTS RESERVED. This drawing is an instrument of service and is the sole property of Asher Architects. Use of this

drawing is restricted to the original site for which it was prepared. Any reuse, reproduction, or publication of this drawing by any method in whole or in part without written consent of the architect is

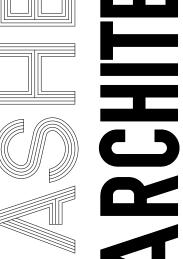


a: 512 5th St. BERTHOUD CO. 80513 p: 970-532-9970

w. AsherArch.com e: David@AsherArch.com


FOR CONSTRUCTION



PROJECT INFORMATION: DOCUMENT DATE: 1/12/2022 2:49:14 PM **DOCUMENT PHASE: CONSTRUCTION DOCUMENTS** 

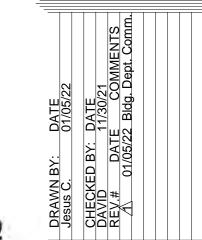



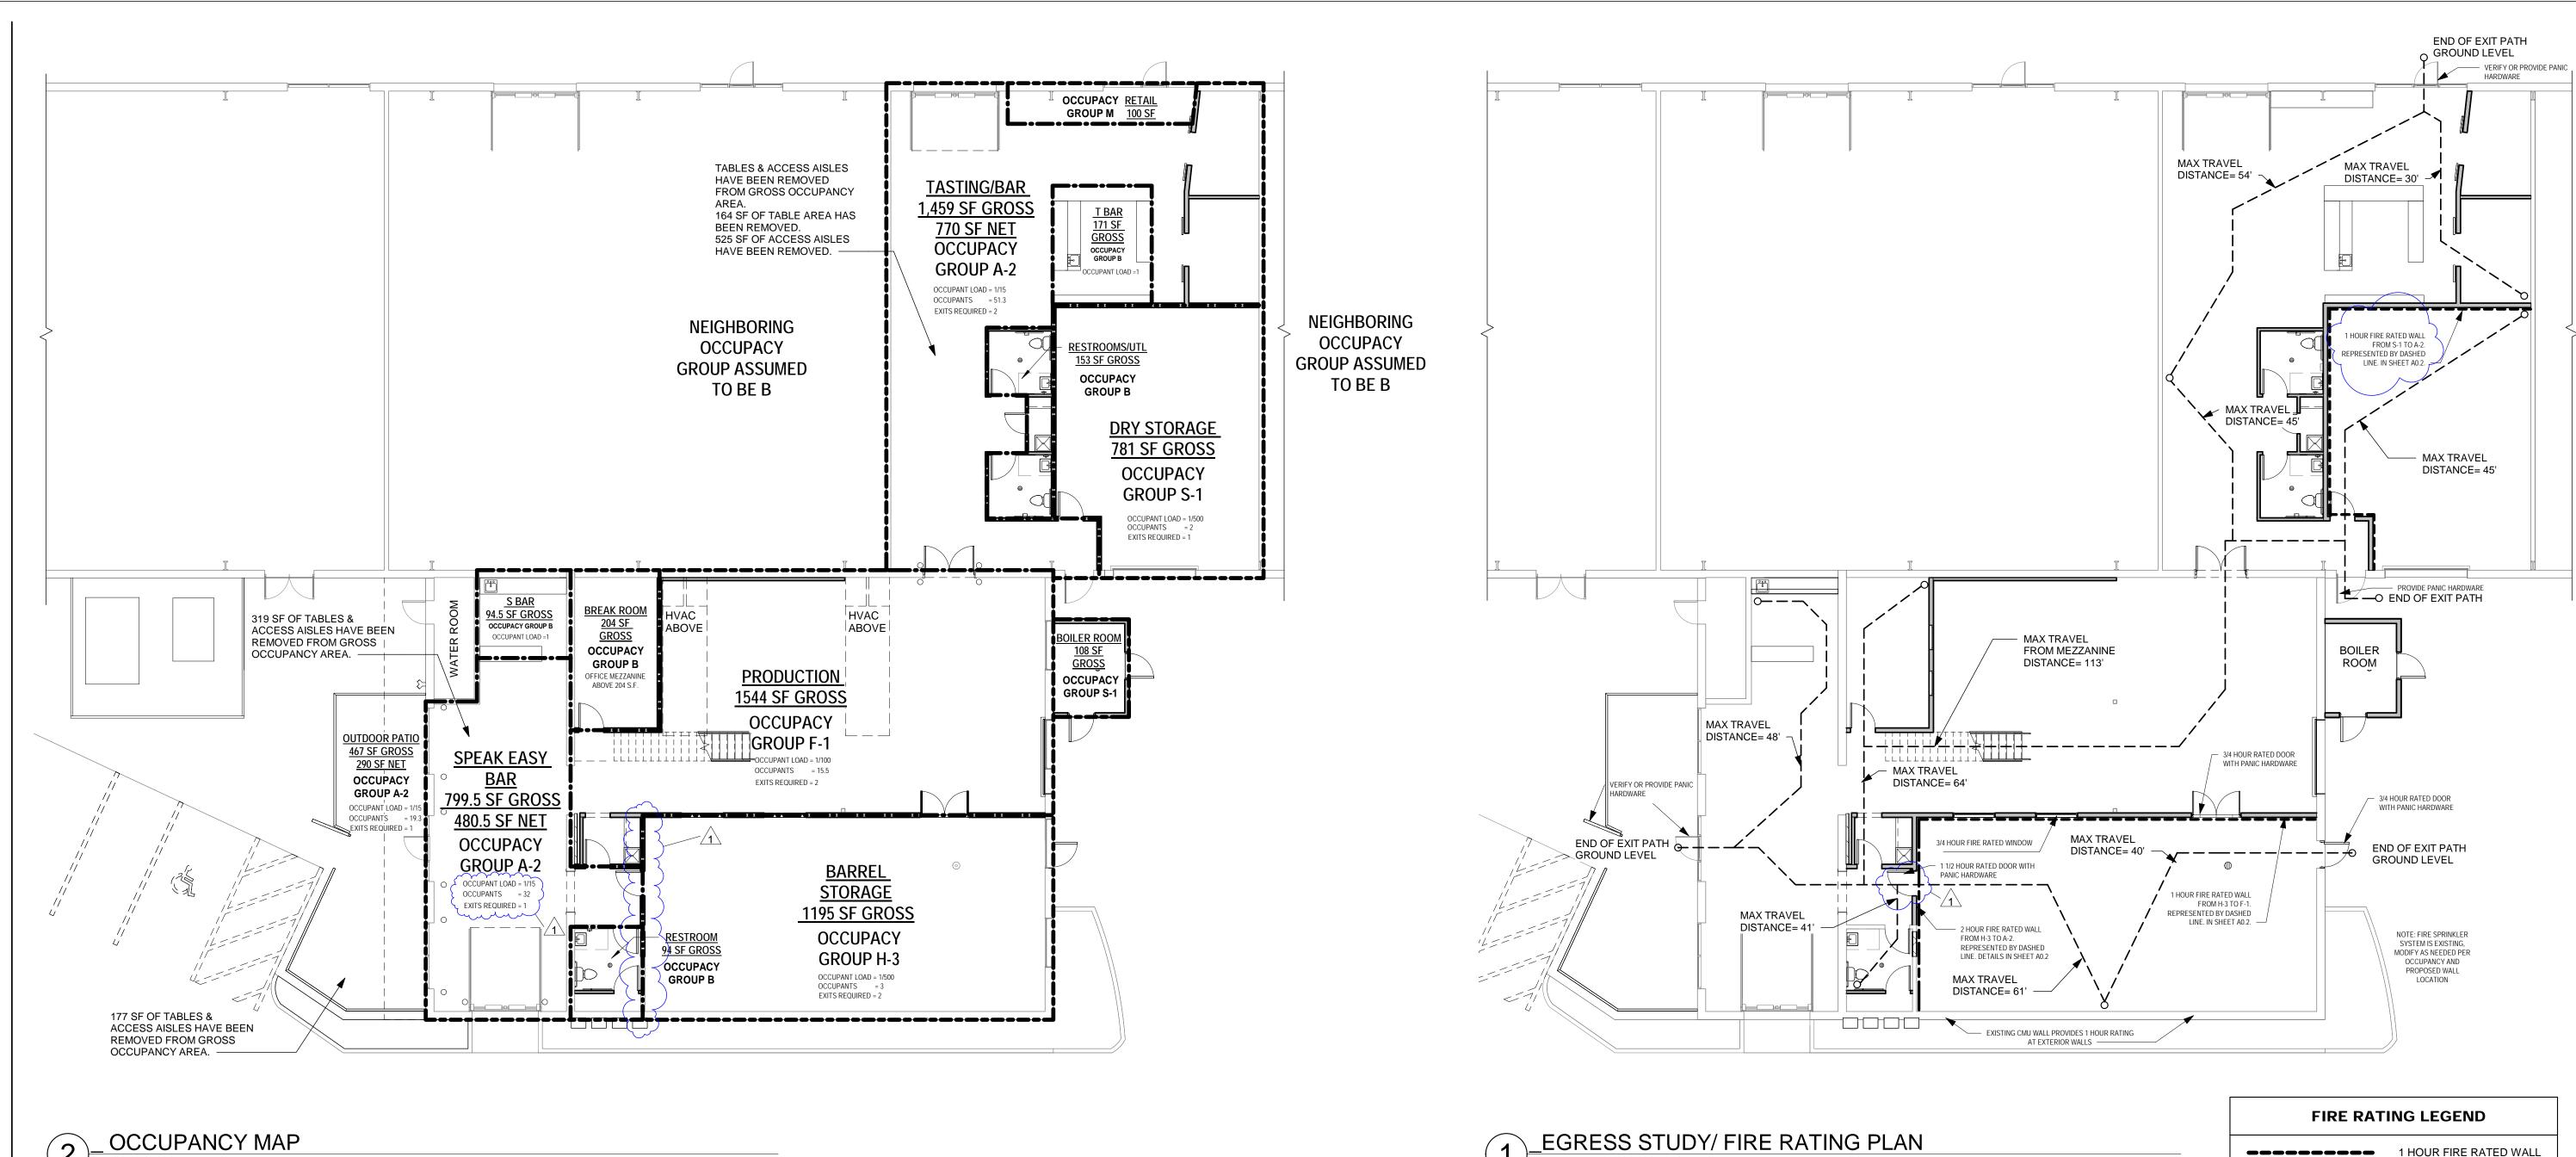

 $(2)^{\frac{1}{1!} = 10! - 0!}$ 

A-2

CODE STUDY:

Applicable Codes 2018 International Building Code, 2018 International Existing Building Code 2018 International Plumbing Code, 2018 International Mechanical Code 2020 National Electric Code, 2018 International Fire Code 2018 International Energy Conservation Code Per Alternate Means Request ICC/ANSI a117.1 2009 Accessible and Useable Building and Facilities

Insulation Requirements: IECC/1 Thermal envelope is existing from core & shell permit. New doors will be insulated with U value of 0.3 or better.

Construction Type: (2018 IBC Tables 506.2 pg. 109-110 and Chapter 6) Type 2B With fire suppression Per core + Shell docs.

= 19,133 S.F Building Footprint Total Tenant Area Total = 6,809 S.F. (204 SF Mezzanine)

Mezzanine floor area is less than one-third of the production room floor area per 2018 IBC Section 505.2 Occupancy Groups: (2018 IBC Sections 303 - 312 pg. 45-54)

= 2,258.5 S.F. = 1,195 S.F.H-3 (Barrel Storage Room) (Dry Storage Room/ Boiler Room) = 889 S.F. (Processing / Distilling Room) = 1,544 S.F. (Break Room) Circulation+ Bars+Restrooms = 716.5 S.F. (Retail within Tasting Room) = <u>100 S.F.</u>

Total = 6,703 S.F. = 467 S.F.

Occupancy Separation: (IBC 2018 Table 508.4 pg. 115) H3 and B,F1,M,S1 occupancy groups require 1 hour fire barrier separation. -H3 and A occupancy groups require 2 hour fire separation. ∠-S1 and A-2 required to be 1hr separation.

Allowable Height and Area: Sprinkled Type 2B Structure (IBC 2018 Tables 504.4, 504.3 and 506.2 pg.

A-2 = 11,500 Sq. Ft. 3 Story 75 Foot Max Height = 14,000 Sq. Ft. 2 Story 55 Foot Max Height = 18,000 Sq. Ft. 4 Story 75 Foot Max Height

Allowable area modification is not required for this structure. No allowable areas are exceeded (IBC 2018 Tables 504.4 and 506.2 pg. 106-110)

# The primary on-site hazardous materials intended for this facility are:

A-2 (Outdoor Patio)

-Flammable and Combustible Liquids: Ethanol (Ethyl Alcohol, C2H5OH) A liquid in aqueous concentrations. Ethanol is water miscible (Mixes uniformly with water)

Flammable and Combustible liquids must comply with all applicable code requirements of the 2018 IFC including chapter 50 -Hazardous materials general provisions and chapter 57 Flammable and Combustible

The product being distilled within this facility is anticipated to be between 40% and 80% Ethanol Content by Volume. Classifications are listed below for 40% to 90% alcohol content

Alcohol Classification: Ethanol Content (By Volume)	Flash Point (Closed Cup)	2018 IFC Product Class
90%	65 F	Flammable liquid class IB
80%	65 F	Flammable liquid class IB
70%	70 F	Flammable liquid class IB
60%	72 F	Flammable liquid class IB
50%	75 F	Flammable liquid class IC
40%	79 F	Flammable liquid class IC

Note: Concentrations of ethanol below 20% in the ranges expected after fermentation (prior to distillation) are classified in accordance with the distilled Spirits Council and the 2018 IFC as Combustible Liquids Class II

Maximum allowable quantities per 2018 IBC Table 307.1(1) Storage Liquid Gallons Use-Closed System Gallons Group when Qty. is Exceeded Flammable Liquid IB less than 240 (fire sprinkled) less than 240 (Fire Sprinkled)

**Use-Closed System Details:** -Copper Sky Distillery is proposing a 230 gallon capacity closed vessel still that will receive approximately 190 gallons of Fermented Mash. -The still will be heated to approximately 212 degrees Fahrenheit using a fully closed internal steam coil. The Still is equipped with pressure release valves, and monitored by two continuously operating cameras.

-The still and the condenser are located within a containment area with stainless steel floor drains -Each distillation will produce around 30 gallons of 40-80% ABV (80-160 proof) in about 5 hrs.

Storage Details: - Distillate is transferred into 53-gallon wood barrels - Approximately 100 barrels will be stored at a time within the barrel storage room.

- Barrels will be stored on metal holding racks, 2 barrels high.

-Once the product has finished aging within the barrel storage room, the barrels are taken to the spill containment area for bottling.

-The product is bottled into 750 ml glass bottles and packages with 6 bottles per case and 50 cases per pallet. **General Notes:** Combustible Dusts may also be present on this site in limited quantities, and appropriate precautions should be taken including frequent cleaning to avoid dust accumulation. Grains, sugars, or any powdered product should be evaluated with respect to combustible dust

-Copper Sky distillery purchases their grain products from Root Shoot Malting. Root Shoot Provides milled bagged grain products, no milling takes place within the Copper Sky facility. Milled grain are added directly to water to prevent air born dust.

#### Boiler Requirements: -The alcohol still is heated via an on site boiler

Boiler size = 1,080,000BTU

-Boiler shall be inspected by the state division of Oil & Public safety boiler inspection program. Contact Mr. Tom Martinez at (970) 215- 9539 or tom.m.martinez@state.co.us to schedule required inspection. Please verify complaince.

-Per 2018 IBC Table 509 pg. 116- 1 hour fire separation or sprinkler system is required for boilers over 400,000 BTU or over 15 psi or 10

#### - 2 Exits are required Per 2018 IBC section 1006.2.2.1 For a boiler exceeding 400,000 BTU's. - Fire Sprinkler system will be provided.

Occupant Loads: (2018 IBC Table 1004.5 pg.259) See occupancy map for occupant load areas and details. -Tables, Access Aisles and wall thickness have been removed from net area calculations.

> 770 Sq. Ft. / 1 Occ. per 15 Sq.Ft = 51.3 Occupants (Southwest Tasting room+ Patio) 770.5 Sq. Ft. / 1 Occ. per 15 Sq.Ft = 51.3 Occupants 1,195 Sq. Ft. / 1 Occ. per 500 Sq.Ft = 3 Occupants (Barrel Storage Room) (Dry Storage Room/ Boiler Room) 889 Sq. Ft. / 1 Occ. per 500 Sq.Ft = 2 Occupants

(Processing / Distilling Room) 1,544 Sq. Ft. / 1 Occ. per 100 Sq.Ft = 15.5 Occupants (Offices + Restrooms) 716 Sq. Ft. / 1 Occ. per 150 Sq.Ft = 4.8 Occupants (Retail within Tasting room) 100 Sq. Ft. / 1 Occ. per 60 Sq.Ft = 2 Occupants

Total Code Occupants = 130.1 Occupants

Accessibility Requirements: (Chapter 11 IBC) -60% of public entrances shall be accessible per 2018 IBC Section 1105.1 pg.307 -Provide clear floor area at all doors and fixtures as shown within this plan set and per ICC A117.1 Section 404.2.3

Requirements within existing structures (IEBC): -No area of this building will become less safe due to the proposed improvements per IEBC Section 701.2 This remodel is a change of occupancy based on the IEBC

#### Means of Egress: Accessible means of egress shall meet the requirements of Chapter 10

Egress Distance Requirements: (2018 IBC Table 1017.2 pg. 285)

-A-2 Exit travel distance max = 250 -H-3 Exit travel distance max = 150' -F-1, Exit travel distance max = 250' -B Exit travel distance max = 300'

-M Exit travel distance max = 250'

Common Path Egress Requirements: (2018 IBC Table 1006.2.1 pg. 262) -A-2 occupancy common path egress travel distances are less than 75' and max occupant load 49 -H-3 occupancy common path egress travel distances are less than 25' and max occupant load 3 -F-1 occupancy common path egress travel distances are less than 100' and max occupant load 49 -B occupancy common path egress travel distances are less than 100' and max occupant load 49

-M occupancy common path egress travel distances are less than 75' and max occupant load 49

-For spaces required to have 2 exit paths, Dead end corridors not to exceed 50' per 2018 IBC Section 1020.4 exception 2 pg.

# **Egress illumination** (2018 IBC Section 1008 pg.264.)

-The means of egress, including the exit discharge, shall be illuminated at all times -Illumination shall not be less than 1 foot-candle at the walking surface level as required per IBC 2018 Section 1008.2.1 -Provide battery backup egress illumination within the egress pathway 2018 IBC Section 1008.3.1 -See electrical engineering plans for emergency lighting locations

<u>Fire rated Glazing:</u>
Per 2018 IBC table 716.1 (2) for glazing areas over 100 sq. in. provide fire rated glazing with D-H-45 markings. Per 2018 IBC table 716.1 (3) provide a 3/4 hour rated window assembly with OH-45 or W-60 Rating markings.

# **Door Requirements:**

-Minimum clear width at all egress doors is 32". Maximum nominal door width is 48" per 2018 IBC section 1010.1.1 -Landings shall be provided at each side of all doorways with a minimum width equal to the door width and a length of 44" minimum

2 HOUR FIRE RATED WALL

per 2018 IBC Section 1010.1.6 -Doors in a series shall be provided with 48" minimum plus the width of the door swinging into the space. Doors in a series shall swing in the same direction or away from the space between the doors per 2018 IBC Section 1010.1.8

Door swing 2018 IBC Section 1010.1.2 -Egress doors shall be pivot or hinge type doors.

Exception: office, storage, or factory areas with less than 10 occupants. -Egress doors shall swing in the direction of travel unless serving areas will less than 50 occupants and not an H occupancy group per 2018 IBC Section 1010.1.2.1

Thresholds
Thresholds at door openings shall not exceed 1/2" in height per 2018 IBC Section 1010.1.7

Egress doors shall be readily openable from the egress side without a key or special knowledge per 2018 IBC Section 1010.1.9 -Accessible doorways shall not require turning of the wrist to operate. provide lever arm knobs or push/pull hardware per 2018 IBC -Unlatching of egress doors shall not require more than one operation per 2018 IBC 1010.1.9.6

The egress door from the H-3 occupancy to the F-1, B Occupancy are required to have a 3/4 hour fire rating to the exterior per 2018 IBC table 716.1 (2)

#### Restroom Requirements: (2018 IBC Table 2902.1 pg.587-589) Water Closets Required

-Provide panic hardware along the egress path for H & A occupancy areas.

= 1 per 25 @ 2.4 men/ 2.4 women = 0.096Business = 1 per 100 @ 1 men/ 1 women = 0.01Storage = 1 per 100 @ 7.75 men/ 7.75 women = 0.078Factory / Industrial Assembly = 1 per 40 @ 51.3 men/ 51.3 women = 1.28 = 1 per 500 @ 1 men/ 1 women Mercantile = 0.002

= 1.47 men, 1.47 women. 1 Men's restroom with one toilet + 1 Woman's restroom with one toilet + 1 Unisex Toilet are provided within the proposed building

# Lavatories Required

= 1 per 40 @ 2.4 men/ 2.4 women = 0.06Business = 0.01= 1 per 100 @ 1 men/ 1 women Storage Factory / Industrial = 1 per 100 @ 7.75 men 7.75 women = 0.078= 1 per 75 @ 51.3 men/ 51.3 women = 0.684Assembly = 1 per 750 @ 1 men/ 1 women = 0.001Mercantile

= 0.83 men, 0.83 women.

1 Sink is provided within each of the three restrooms.

1 Service sink is available for cleaning purposes


# Finish Material Requirements

Millwork such as interior doors, door frames, window frames and sashes are allowed to be combustible materials per 2018 IBC Section 603.1 number 6

Wall finish materials are allowed to be combustible materials with a Class B flame spread index per 2018 IBC Section 603.1 number 7 page 121 and Section 803



© ASHER ARCHITECTS B.CORP. ALL RIGHTS RESERVED. This drawing is an instrument of service and is the sole property of Asher Architects. Use of this drawing is restricted to the original site for which it was prepared. Any reuse, reproduction, or publication of this drawing by any method in whole or in part without written consent of the architect is prohibited.

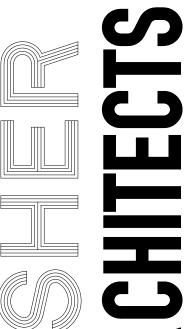




a: 512 5th St. BERTHOUD CO. 80513 p: 970-532-9970


w. AsherArch.com e: David@AsherArch.com


FOR CONSTRUCTION



PROJECT INFORMATION: 21-C26 DOCUMENT DATE: 1/12/2022 2:49:18 PM **DOCUMENT PHASE: CONSTRUCTION DOCUMENTS** 

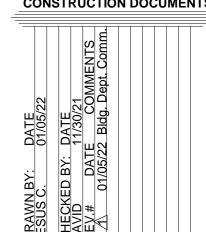

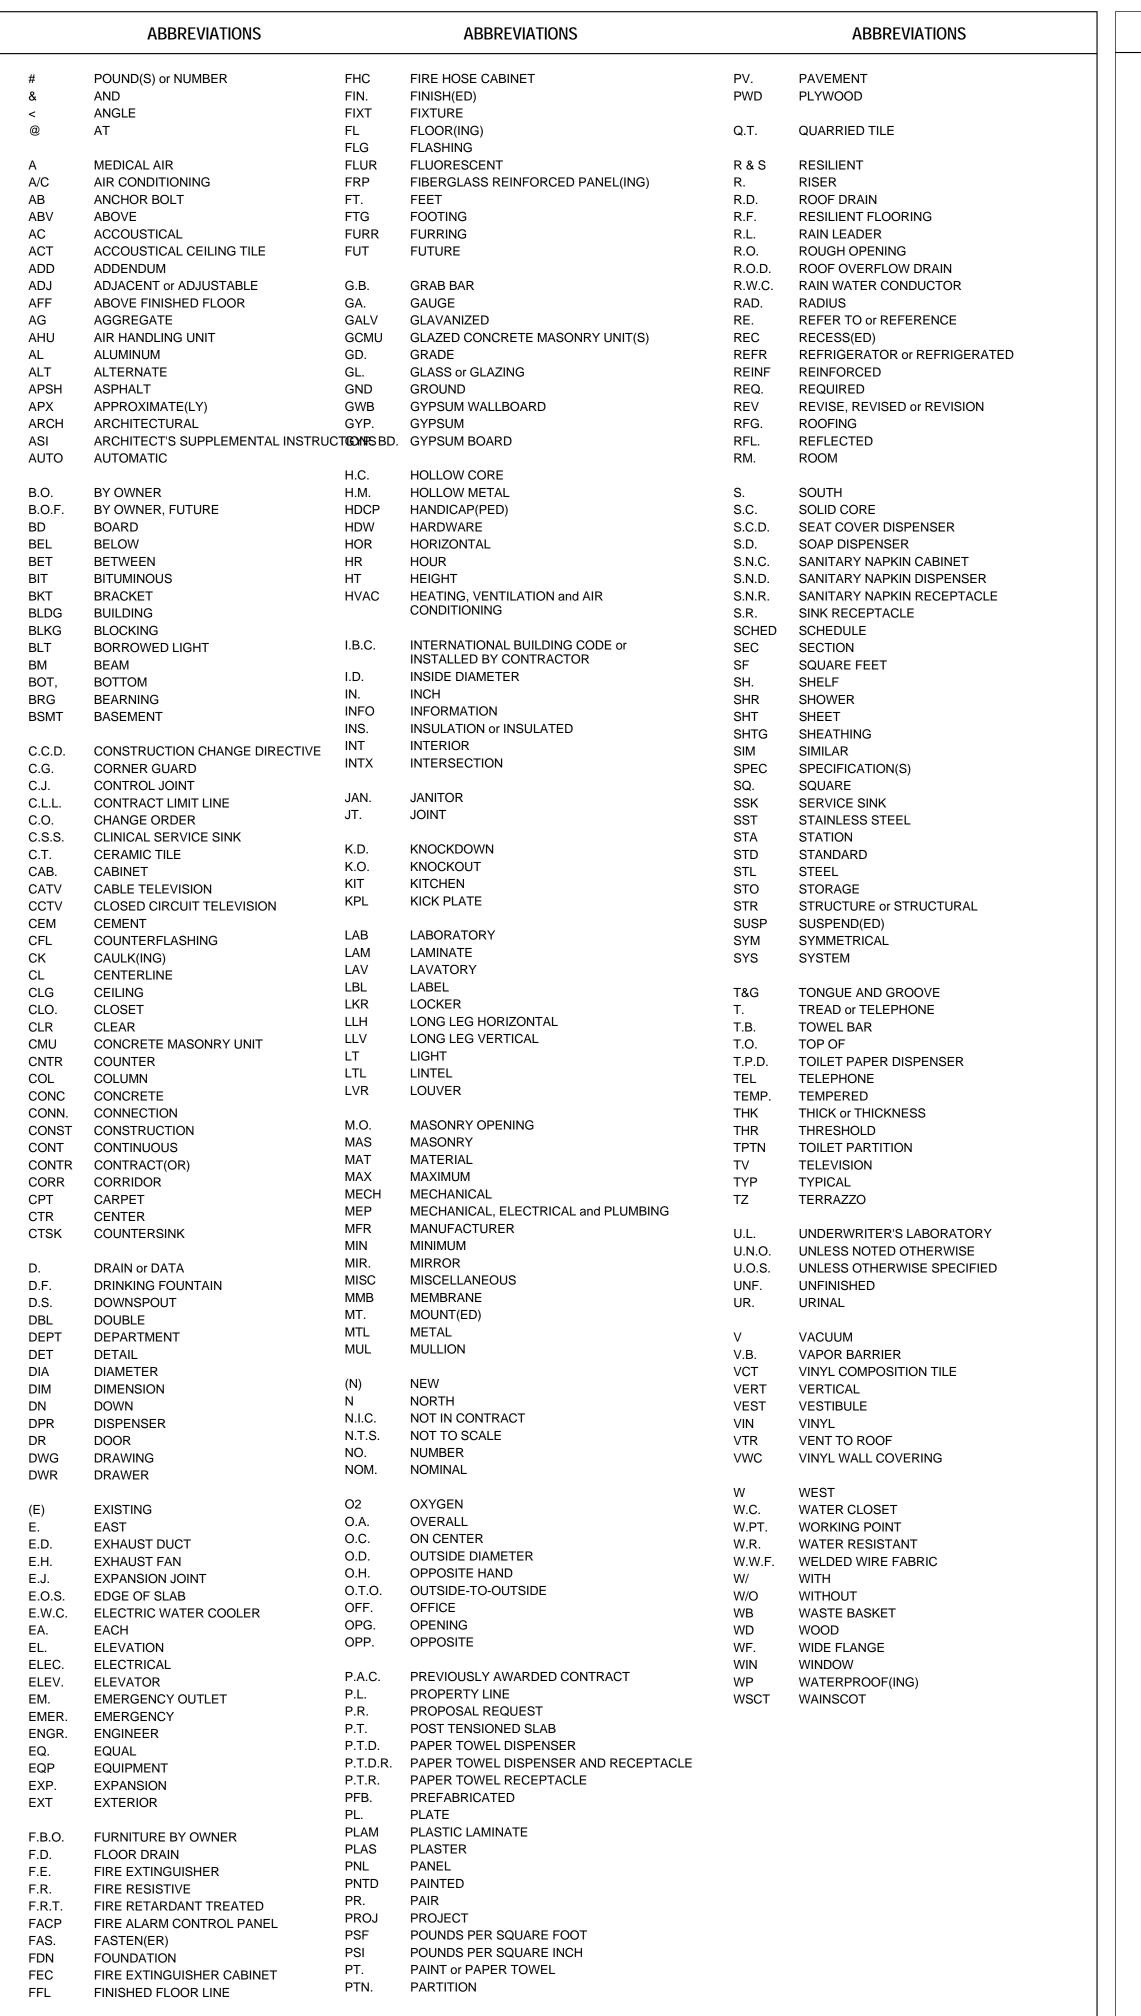

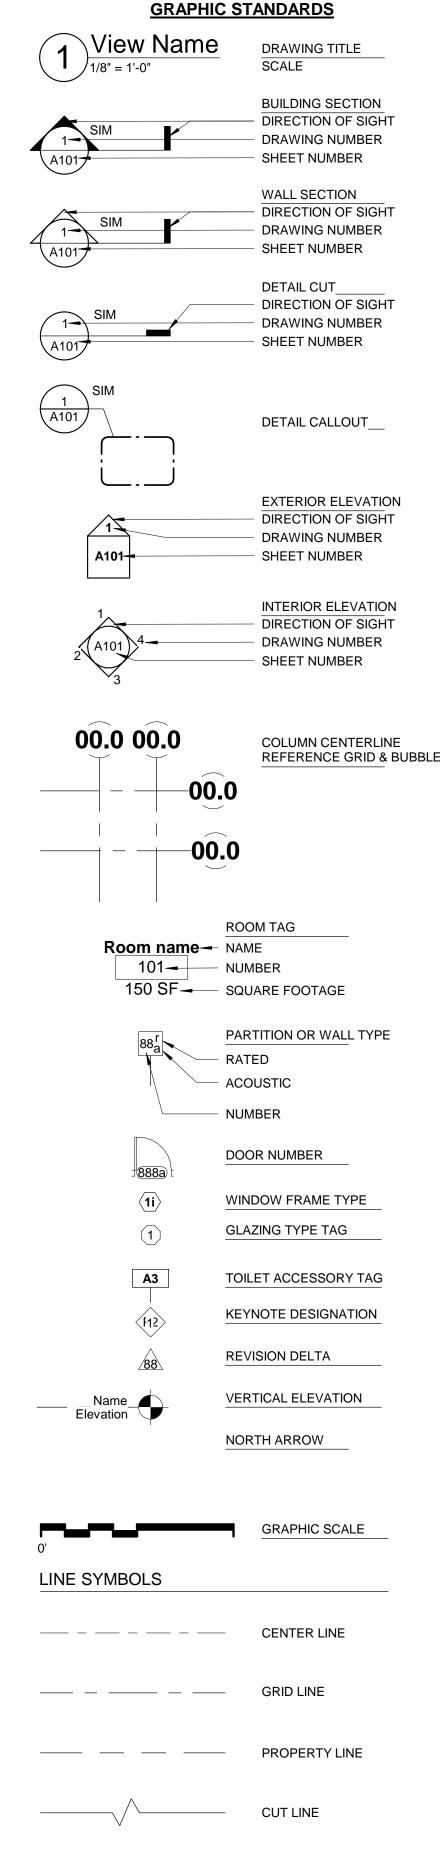


PLAN MATCH LINE

**ARCHITECTURAL** 

CONS	CONSTRUCTION						
PLAN AND SEC	TION						
	EARTH, UNDISTURBED						
	GRAVEL						
	CONCRETE, CAST IN PLACE, PRECAST						
	BRICK						
	CONCRETE MASONRY UNIT (CMU)						
	STONE						
	WOOD (ROUGH)						
	WOOD (ROUGH) BLOCKING OR SHIM						
	WOOD (FINISH)						
	SAND, PLASTER, MORTAR, GROUT						
	METAL, STRUCTURAL STEEL STUDS						
	RIGID INSULATION						
	BATT, LOOSE-FILL INSULATION						
ELEVATION							
	MASONRY						
	SIDING						
	CONCRETE , GYPSUM BOARD, PLASTER						
	TILE						

Name	Area		
TASTING/BAR	101	T.O. SLAB	1630 SF
DRY STORAGE	102	T.O. SLAB	781 SF
M/RR	103	T.O. SLAB	65 SF
N/RR	104	T.O. SLAB	65 SF
UTL	105	T.O. SLAB	23 SF
PRODUCTION	106	T.O. SLAB	1544 SF
BARREL STORAGE	107	T.O. SLAB	1195 SF
BREAK ROOM	108	T.O. SLAB	204 SF
SHARED RR	109	T.O. SLAB	94 SF
SPEAK EASY BAR	110	T.O. SLAB	894 SF
RETAIL	111	T.O. SLAB	100 SF
BOILER ROOM	112	T.O. SLAB	108 SF
T.O. SLAB: 12			6701 SF
OFFICE	201	T.O. MEZZANINE	204 SF
T.O. MEZZANINE: 1			204 SF
Grand total: 13			6905 SF

annum and a second	00 05	T.O. SLAB	103	
	65 SF	T.O. SLAB	104	
Approved January	23 SF	T.O. SLAB	105	
© ASHER ARCHIT	1544 SF	T.O. SLAB	106	
ALL RIGHTS RESI	1195 SF	T.O. SLAB	107	
This drawing is an	204 SF	T.O. SLAB	108	
service and is the s	94 SF	T.O. SLAB	109	
Asher Architects. U drawing is restricte	894 SF	T.O. SLAB	110	
site for which it was	100 SF	T.O. SLAB	111	
reuse, reproduction	108 SF	T.O. SLAB	112	
of this drawing by a	6701 SF	-		
whole or in part wit consent of the arch	204 SF	T.O. MEZZANINE	201	
prohibited.	204 SF			
	6905 SF			

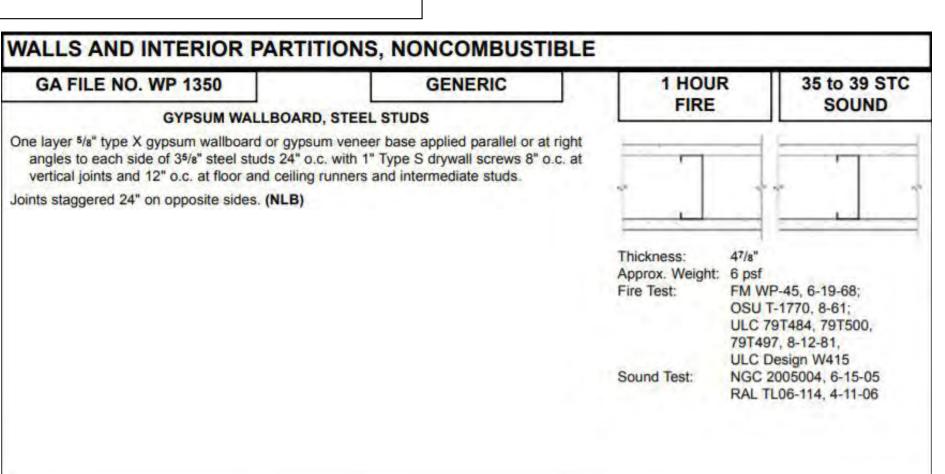

# INTERIOR FIRE WALL ASSEMBLY DETAIL

LOCATED ALONG NORTH WALLS OF BARREL STORAGE ROOM.

GA FILE NO. WP 1522	GENERIC	2 HOUR	55 to 59 STC
GYPSUM WALLBOAR	D, STEEL STUDS	FIRE	SOUND
Base layer 5/s" type X gypsum wallboard or gyps angles to each side of 35/s" steel studs 24" of Face layer 5/s" type X gypsum wallboard or right angles to each side with 15/s" Type S dr	o.c. with 1" Type S drywall screws 24" o.c. gypsum veneer base applied parallel or at	-	
loints staggered 24" each layer and side. Soun stud space. (NLB)	d tested with 31/2" glass fiber friction fit in		TTHINGTON
		Thickness: 61/a' Approx. Weight: 12 p	
			WP 1548 II-495-0236, 1-30-80)
		Sound Test: NRC	CC 818-NV, 2-3-81


ment ment ment ment and the second se

# INTERIOR FIRE WALL ASSEMBLY DETAIL

LOCATED ALONG WEST WALLS OF BARREL STORAGE ROOM.



ary 11, 2022 HITECTS B.CORP. SERVED. n instrument of e sole property of . Use of this cted to the original vas prepared. Any ion, or publication any method in vithout written chitect is

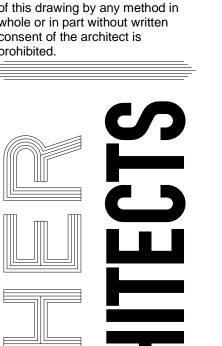



a: 512 5th St. BERTHOUD CO. 80513 p: 970-532-9970

w. AsherArch.com e: David@AsherArch.com





PROJECT INFORMATION: 21-C26 DOCUMENT DATE: 1/12/2022 2:49:19 PM DOCUMENT PHASE: **CONSTRUCTION DOCUMENTS** 

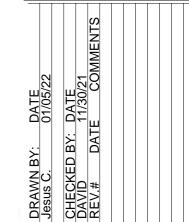

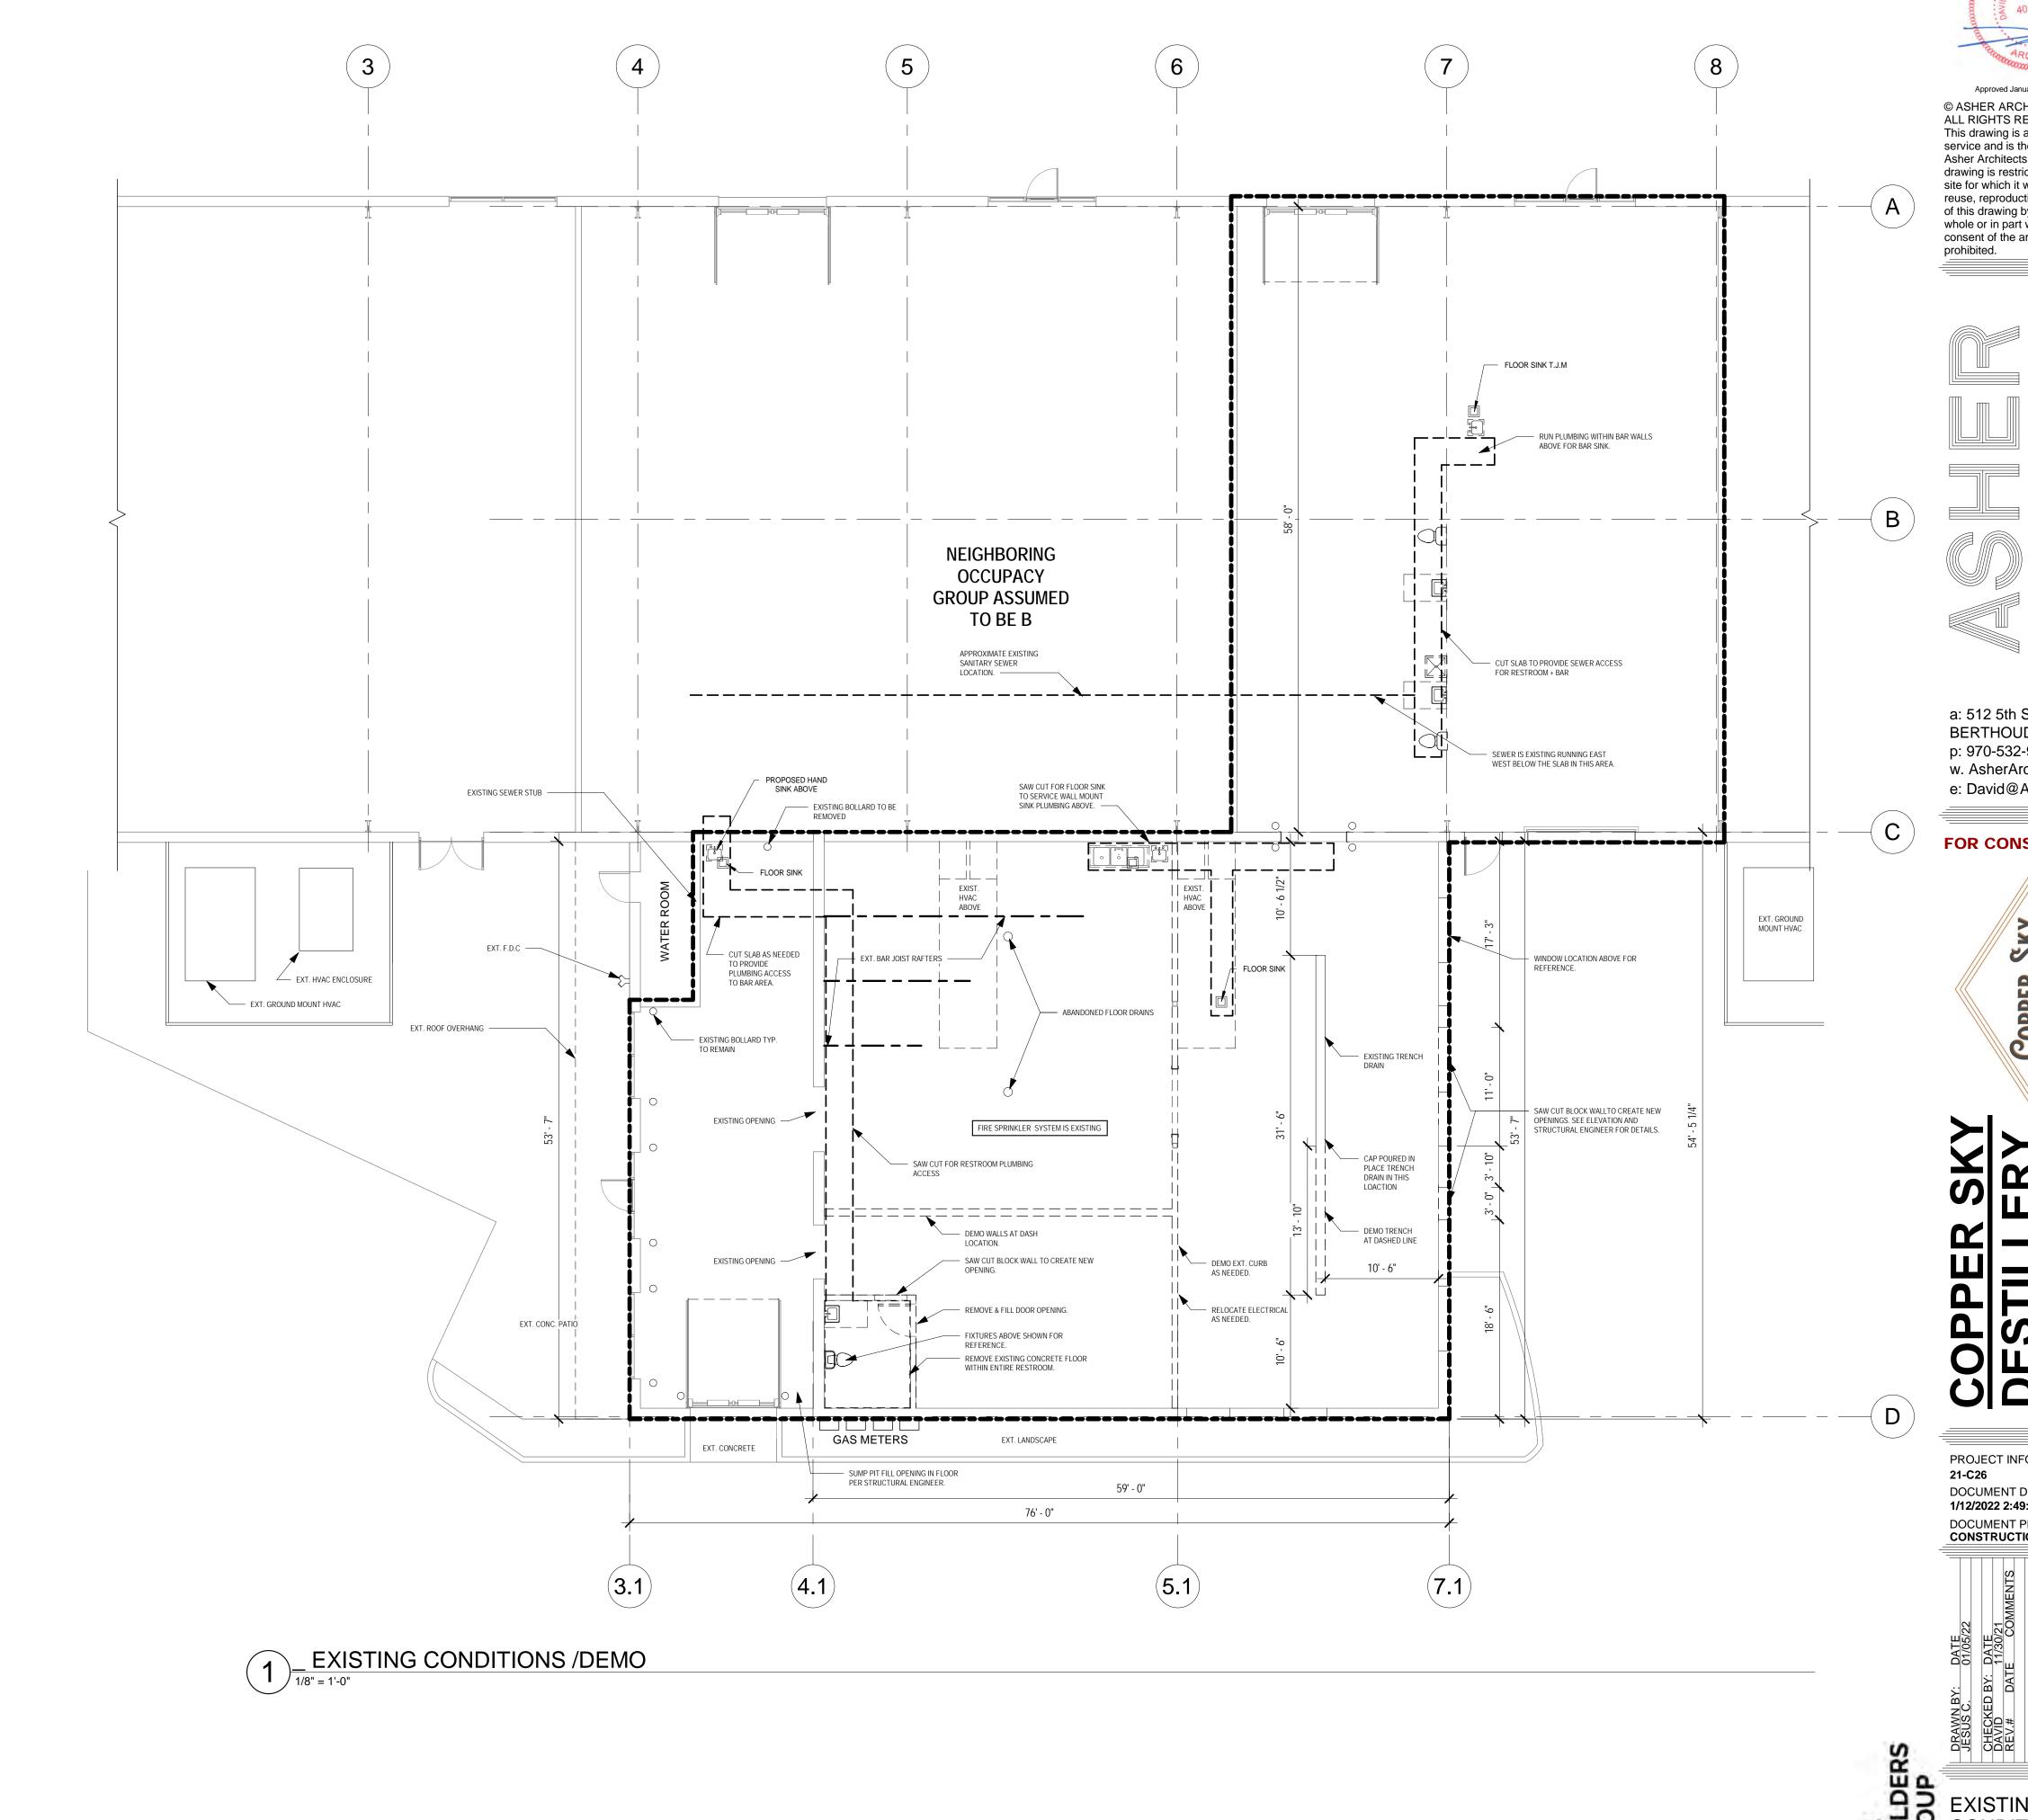

Approved January 11, 2022 © ASHER ARCHITECTS B.CORP. ALL RIGHTS RESERVED. This drawing is an instrument of service and is the sole property of Asher Architects. Use of this drawing is restricted to the original site for which it was prepared. Any reuse, reproduction, or publication of this drawing by any method in whole or in part without written consent of the architect is

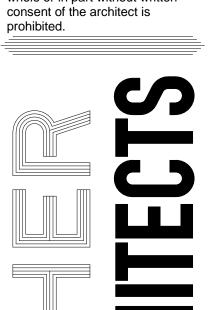

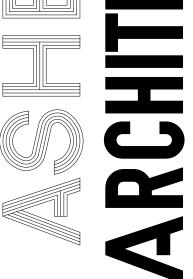


a: 512 5th St. BERTHOUD CO. 80513 p: 970-532-9970 w. AsherArch.com


e: David@AsherArch.com

FOR CONSTRUCTION

COPPER

PROJECT INFORMATION: DOCUMENT DATE: 1/12/2022 2:49:20 PM DOCUMENT PHASE: CONSTRUCTION DOCUMENTS

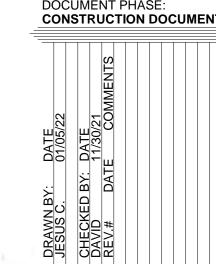

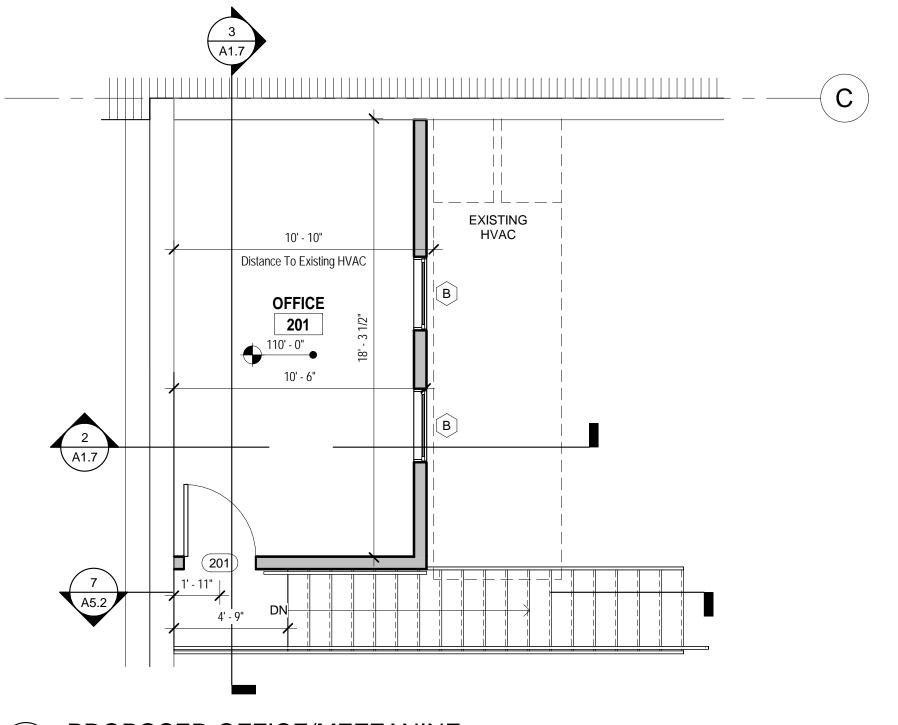

# \_PROPOSED OFFICE/MEZZANINE 2 PROPOSED OFFICE/IVILAZATIVI 1/4" = 1'-0" LOCATED DIRECTLY ABOVE BREAK ROOM

	WINDOW SCHEDULE								
T.O. SLAB A FXD 2 5' - 0" 5' - 0" 3/4 hr Rated Fire V						-			
	Level	TAG	Туре	COUNT	WIDTH	HEIGHT	COMMENTS		
varies B FXD 4 3' - 0" 3' - 0"	. SLAB	Α	FXD	2	5' - 0"	5' - 0"	3/4 hr Rated Fire Window		
	ies>	В	FXD	4	3' - 0"	3' - 0"			
Grand total: 6	nd total: 6								

			DOC	OR SCH	EDULE		
Level	Mark	Type Comments	Width	Height	Comments		Fire Rating
Exterior					\	>	
T.O. SLAB						>	
T.O. SLAB	106B	В	9' - 0"	9' - 0"	Provide Electric Opener	<u> </u>	without
T.O. SLAB	107	A	3' - 0"	7' - 0"	Includes Panic Hardware	(  :	3/4 HR Rated/ With Automatic Closing Device
T.O. SLAB	113A	A	3' - 0"	7' - 0"	Lock set hardware	<u> </u>	3/4 HR Rated/ With Automatic Closing Device
T.O. SLAB	113B	A	3' - 0"	7' - 0"	Lock set hardware	( );	3/4 HR Rated/ With Automatic Closing Device
Exterior: 4	•	•				-	-
Interior						>	
T.O. SLAB						(	
T.O. SLAB	101A	D	6' - 0"	8' - 0"	Electronic Keypad		without
T.O. SLAB	101B	F	2' - 0"	8' - 0"	Black Barn Door Hardware	} '	without
T.O. SLAB	101B	F	2' - 0"	8' - 0"	Black Barn Door Hardware	( )	without
T.O. SLAB	101B	F	2' - 0"	8' - 0"	Black Barn Door Hardware	} '	without
T.O. SLAB	101B	F	2' - 0"	8' - 0"	Black Barn Door Hardware	( )	without
T.O. SLAB	101C	E	2' - 6"	7' - 0"	Lock set hardware	\	without
T.O. SLAB	102	E	3' - 0"	7' - 0"	Electronic Keypad	$\int$	without
T.O. SLAB	103	E	3' - 0"	7' - 0"	Privacy Hardware	١ ح	without
T.O. SLAB	104	E	3' - 0"	7' - 0"	Privacy Hardware	١ _ (	without
T.O. SLAB	106A	С	6' - 0"	8' - 0"	Includes Panic Hardware	$\zeta$ ;	3/4 HR Rated/ With Automatic Closing Device
T.O. SLAB	106C	G	6' - 0"	8' - 0"	Passage Hardware		without
T.O. SLAB	106D	E	3' - 0"	7' - 0"	Passage Hardware	}	without
T.O. SLAB	108	E	3' - 0"	7' - 0"	Passage Hardware	١ ح	without
T.O. SLAB	109	E	3' - 0"	7' - 0"	Privacy Hardware	١	without
T.O. SLAB	109A	E	3' - 0"	7' - 0"	Lock set hardware	{	without
T.O. SLAB	110	A	3' - 0"	7' - 0"	Includes Panic Hardware	ξ.	1 1/2 HR Rated/ With Automatic Closing Device
T.O. MEZANINE						2	
T.O. MEZANINE	201	Е	3' - 0"	7' - 0"	Lock set hardware	\ \ \ \ \	without
Interior: 17						<u></u>	( , ,
Grand total: 21							

**DOOR TYPES:** 

FRAME.

HARDWARE.


DOOR TYPE A

= TEMPERED GLASS REQUIRED

DOOR TYPE B

ROOM FINISH SCHEDULE									
						Ceiling	Wall		
Name	Number	Level	Area	Floor Finish	Base Finish	Finish	Finish		
TASTING/BAR	101	T.O. SLAB	1630 SF	Natural	4" Black Rubber Cove Base	Black Paint	Drywall/ Pain		
DRY STORAGE	102	T.O. SLAB	781 SF	Natural	4" Black Rubber Cove Base	No Paint	Drywall/ Pain		
M/RR	103	T.O. SLAB	65 SF	Sealed	4" Black Rubber Cove Base	White Paint	Tile/Paint		
W/RR	104	T.O. SLAB	65 SF	Sealed	4" Black Rubber Cove Base	White Paint	Tile/Paint		
UTL	105	T.O. SLAB	23 SF	Sealed	4" Black Rubber Cove Base	White Paint	Drywall/ Pair		
PRODUCTION	106	T.O. SLAB	1544 SF	Sealed	4" Black Rubber Cove Base	Black Paint	Drywall/ Pair		
BARREL STORAGE	107	T.O. SLAB	1195 SF	Natural	4" Black Rubber Cove Base	Black Paint	Drywall/ Pair		
BREAK ROOM	108	T.O. SLAB	204 SF	Natural	4" Black Rubber Cove Base	White Paint	Drywall/ Pair		
SHARED RR	109	T.O. SLAB	94 SF	Sealed	4" Black Rubber Cove Base	White Paint	Tile/Paint		
SPEAK EASY BAR	110	T.O. SLAB	894 SF	Natural	4" Black Rubber Cove Base	Black Paint	Drywall/ Pair		
RETAIL	111	T.O. SLAB	100 SF	Sealed	4" Black Rubber Cove Base	Black Paint	Drywall/ Pair		
BOILER ROOM	112	T.O. SLAB	108 SF	Natural	4" Black Rubber Cove Base	Black Paint	N/A		
OUTDOOR PATIO	113	T.O. SLAB	467 SF	No Work	N/A	N/A	N/A		
T.O. SLAB: 13			,	•					
OFFICE	201	T.O. MEZZANINE	204 SF	Carpet Tile Optional	4" Black Rubber Cove Base	Black Paint	Drywall/ Pair		
T.O. MEZZANINE: 1 Grand total: 14	1	1	1			1	1		

WALL FINISH:
- NORTH WALLS: DRYWALL/ LIGHT GRAY COLOR
- SOUTH WALLS: DRYWALL/ DARK GRAY COLOR
- EAST WALLS: DRYWALL/ BURNT ORANGE COLO
- WEST WALLS: DRYWALL/ DARK GRAY COLOR

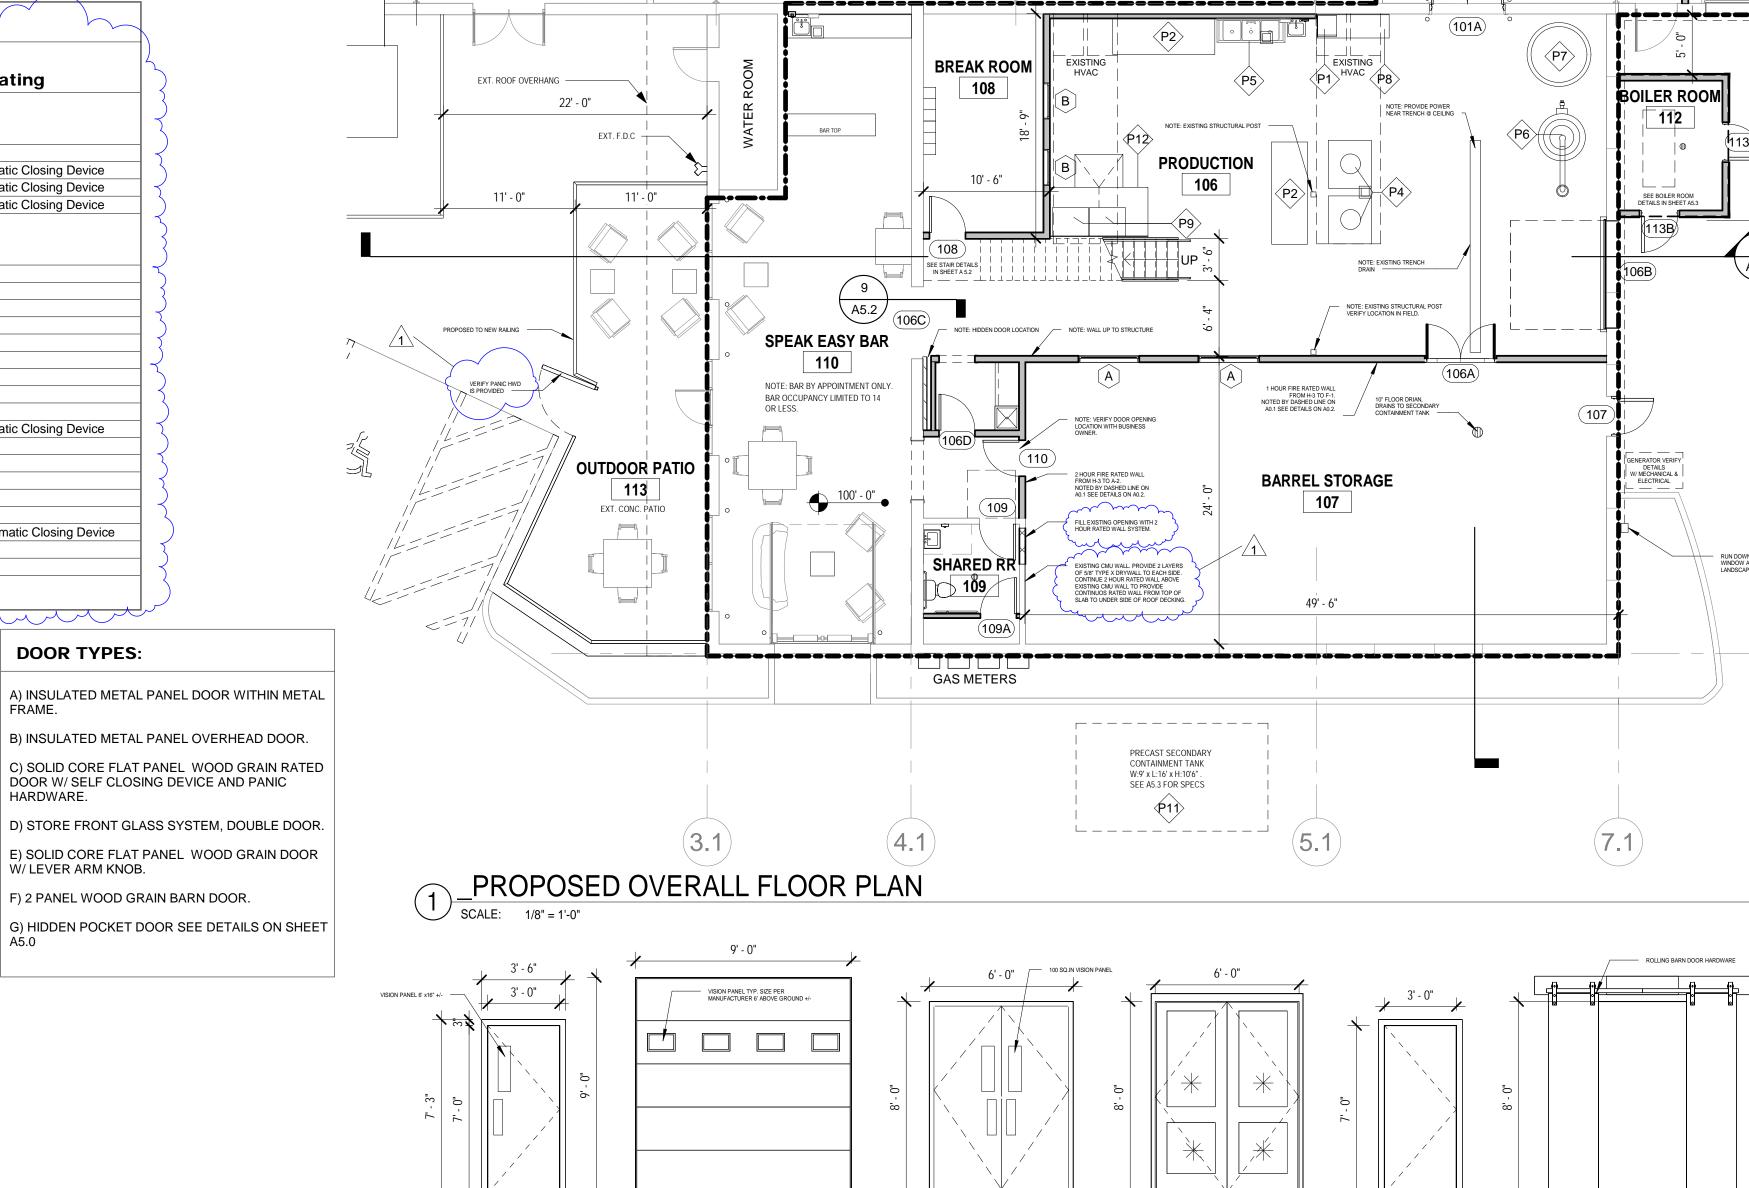

DOOR TYPE C

DOOR TYPE E

DOOR TYPE D

DOOR TYPE F



Approved January 11, 2022 © ASHER ARCHITECTS B.CORP. ALL RIGHTS RESERVED. This drawing is an instrument of service and is the sole property of Asher Architects. Use of this drawing is restricted to the original site for which it was prepared. Any reuse, reproduction, or publication of this drawing by any method in whole or in part without written consent of the architect is prohibited.

PROVIDE OCCUPANT LOAD
SIGNAGE NEAR THE EXIT DOOR
STATING MAX OCCUPANT LOAD= 52

NOTE: FEATURE WALL

DRY STORAGE 102

44' - 7 1/8"

√103

104



a: 512 5th St. BERTHOUD CO. 80513 p: 970-532-9970 w. AsherArch.com

e: David@AsherArch.com


FOR CONSTRUCTION


RUN DOWNSPOUT OVER OVERHEAD DOOR AND DAYLIGHT WITHIN HVAC ENCLOSURE.

EXT. GROUND MOUNT HVAC


SKY SKY COPPER

PROJECT INFORMATION: 21-C26 DOCUMENT DATE: 1/12/2022 2:49:23 PM DOCUMENT PHASE: CONSTRUCTION DOCUMENTS

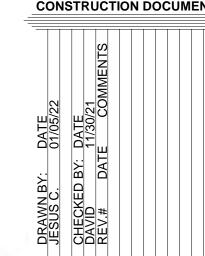

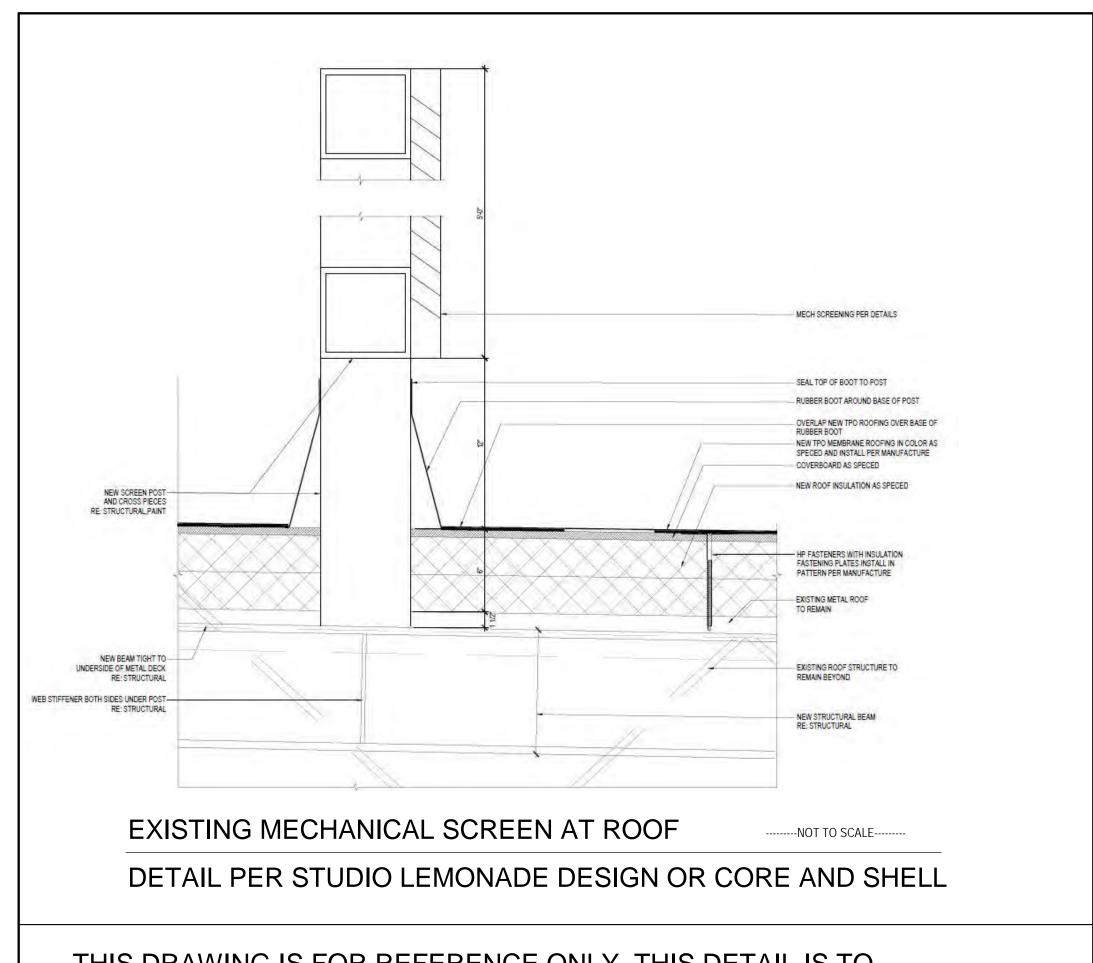


THIS DRAWING IS FOR REFERENCE ONLY. THIS DETAIL IS TO DEMONSTRATE HOW THE EXISTING MECHANICAL SCREENING WAS CONSTRUCTED. THIS DRAWING IS PROPERTY OF STUDIO LEMONADE AND WAS NOT PRODUCES BY ASHER ARCHITECTS.

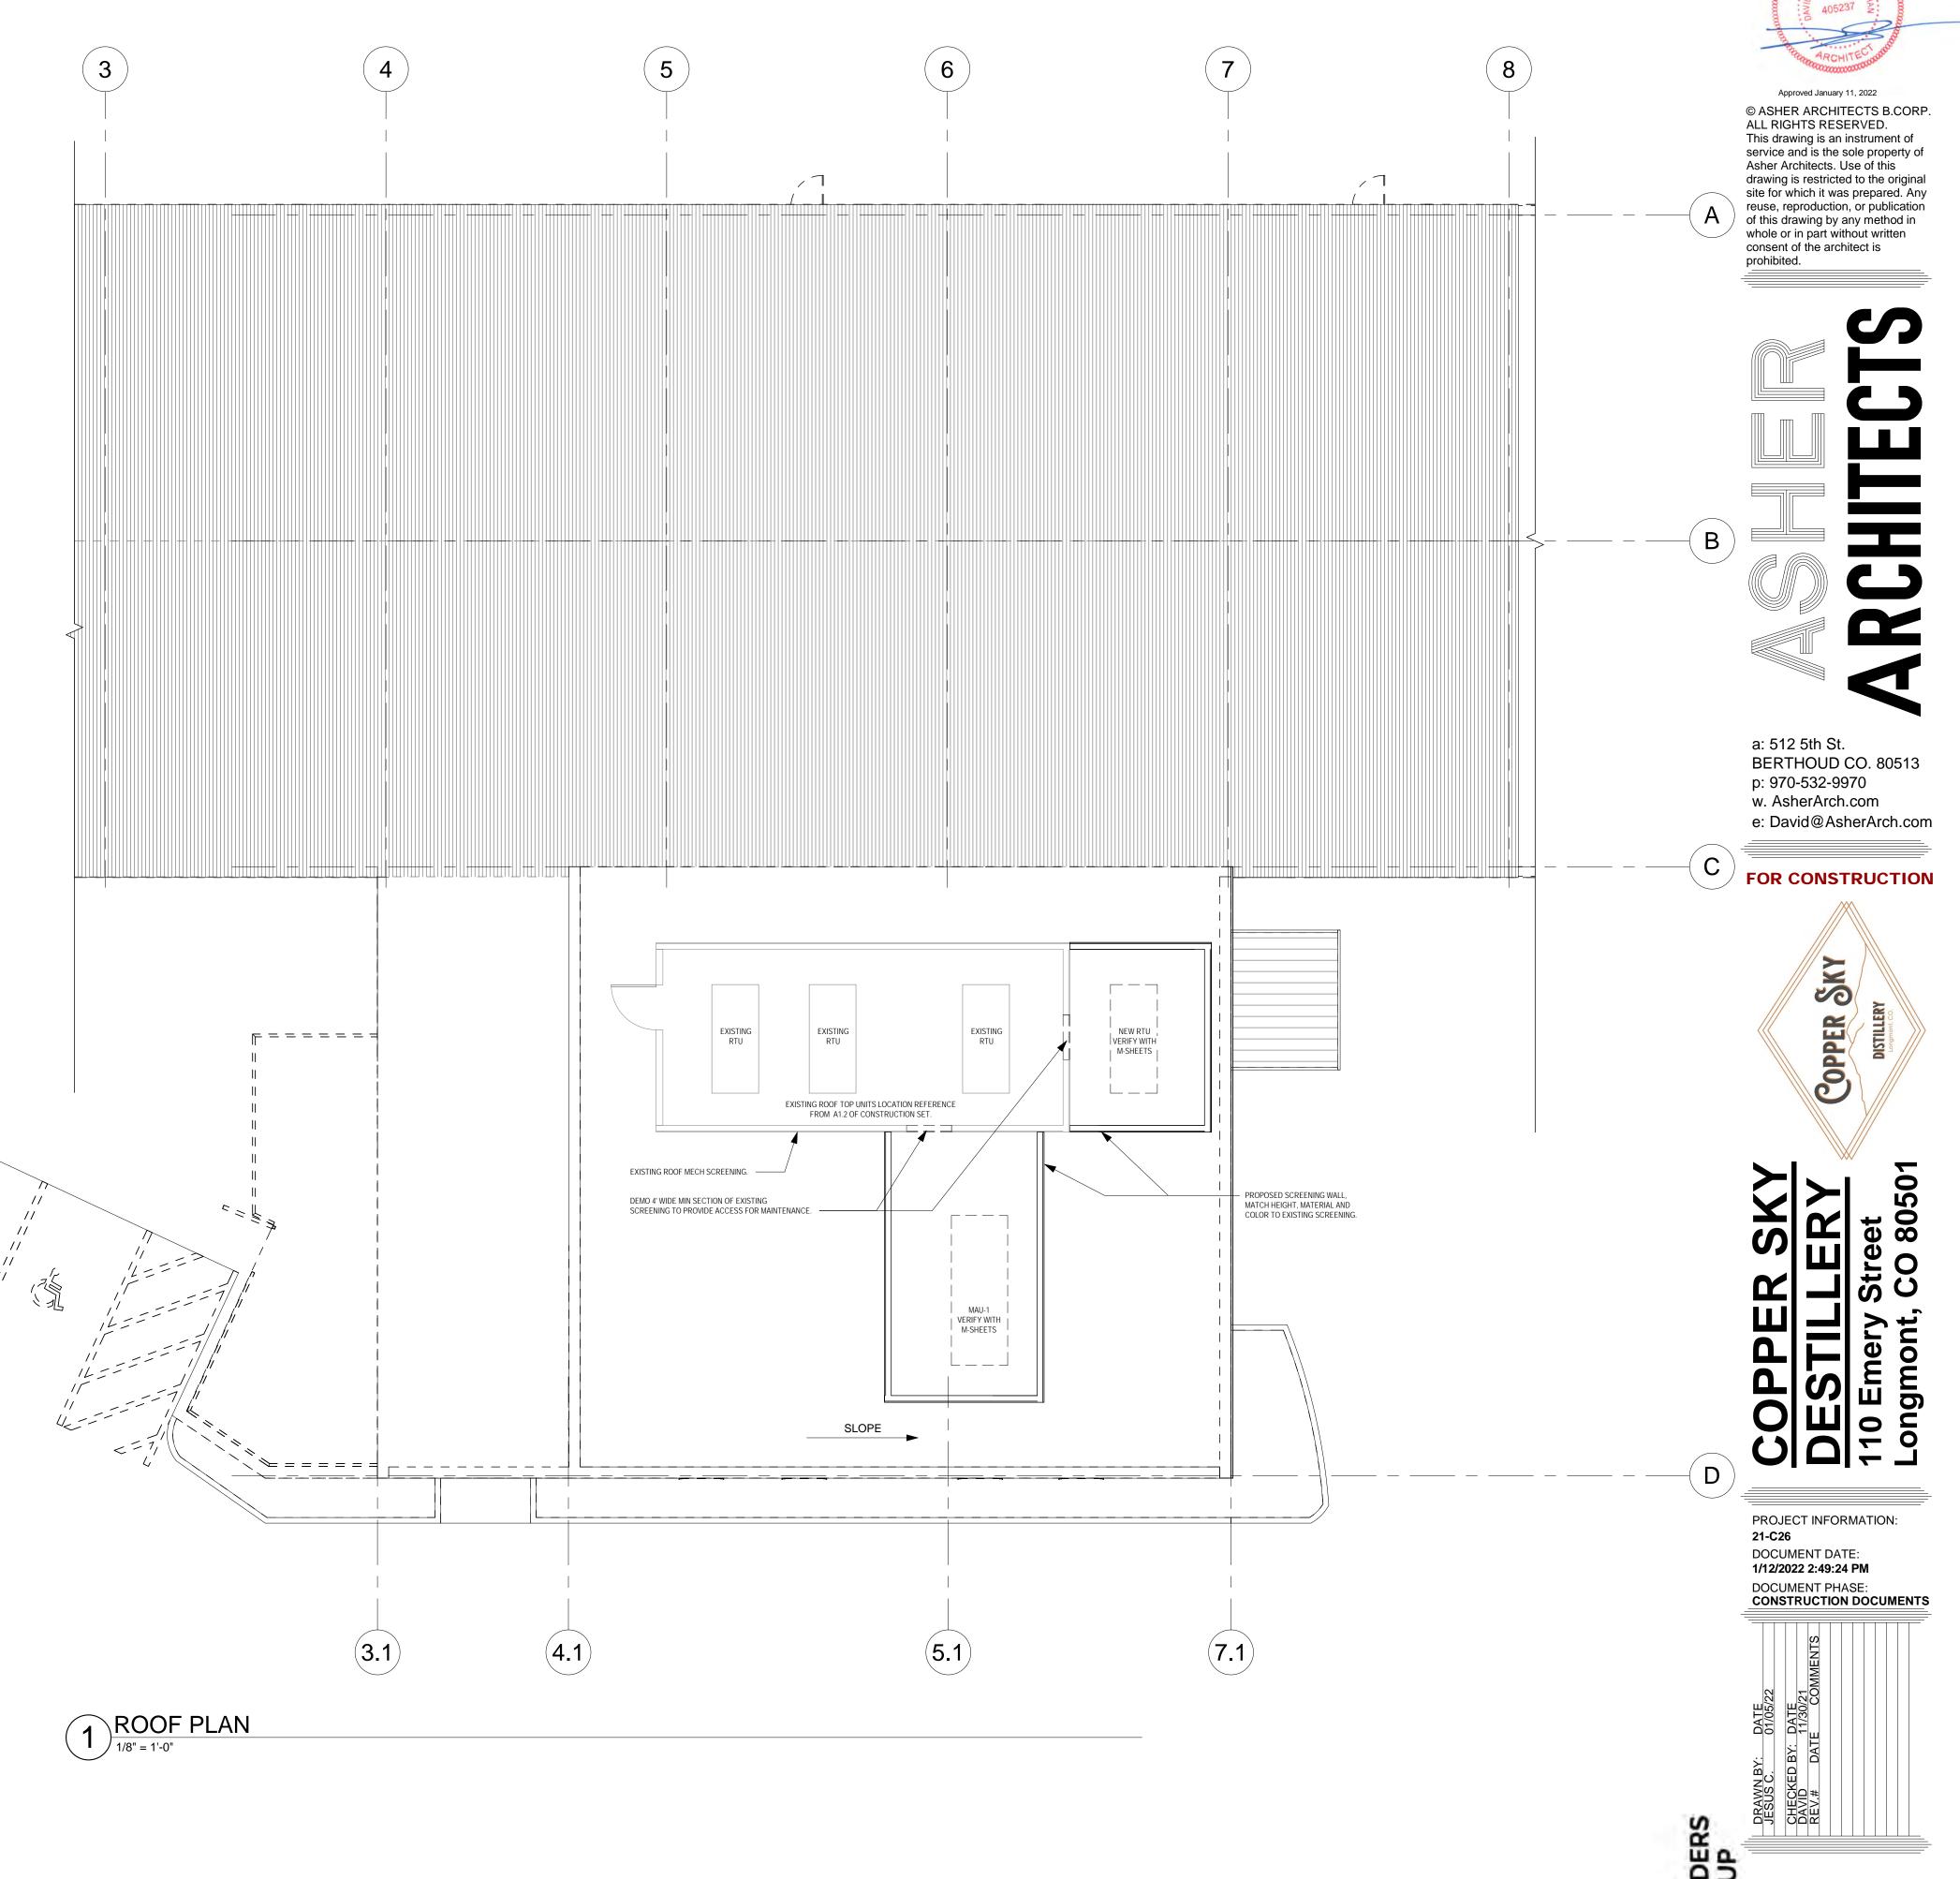


		W	INDOW S	CHEDUL	.E	
					-	
Level	TAG	Туре	COUNT	WIDTH	HEIGHT	COMMENTS
T.O. SLAB	Α	FXD	2	5' - 0"	5' - 0"	3/4 hr Rated Fire Window
<varies></varies>	В	FXD	4	3' - 0"	3' - 0"	
Grand total: 6						•

	DOOR SCHEDULE									
		Туре								
Level	Mark	Comments	Width	Height	Comments	Fire Rating				
Estada d										
Exterior										
T.O. SLAB	400D	Ъ	01 011	01 01	Dravida Flastria Orana					
T.O. SLAB	106B	В	9' - 0"	9' - 0"	Provide Electric Opener	without				
T.O. SLAB	107	A	3' - 0"	7' - 0"	Includes Panic Hardware	3/4 HR Rated/ With Automatic Closing Device				
T.O. SLAB	113A	A	3' - 0"	7' - 0"	Lock set hardware	3/4 HR Rated/ With Automatic Closing Device				
T.O. SLAB	113B	A	3' - 0"	7' - 0"	Lock set hardware	3/4 HR Rated/ With Automatic Closing Device				
Exterior: 4										
Interior										
T.O. SLAB										
T.O. SLAB	101A	D	6' - 0"	8' - 0"	Electronic Keypad	without				
T.O. SLAB	101B	F	2' - 0"	8' - 0"	Black Barn Door Hardware	without				
T.O. SLAB	101B	F	2' - 0"	8' - 0"	Black Barn Door Hardware	without				
T.O. SLAB	101B	F	2' - 0"	8' - 0"	Black Barn Door Hardware	without				
T.O. SLAB	101B	F	2' - 0"	8' - 0"	Black Barn Door Hardware	without				
T.O. SLAB	101C	E	2' - 6"	7' - 0"	Lock set hardware	without				
T.O. SLAB	102	E	3' - 0"	7' - 0"	Electronic Keypad	without				
T.O. SLAB	103	E	3' - 0"	7' - 0"	Privacy Hardware	without				
T.O. SLAB	104	E	3' - 0"	7' - 0"	Privacy Hardware	without				
T.O. SLAB	106A	С	6' - 0"	8' - 0"	Includes Panic Hardware	3/4 HR Rated/ With Automatic Closing Device				
T.O. SLAB	106C	G	6' - 0"	8' - 0"	Passage Hardware	without				
T.O. SLAB	106D	E	3' - 0"	7' - 0"	Passage Hardware	without				
T.O. SLAB	108	E	3' - 0"	7' - 0"	Passage Hardware	without				
T.O. SLAB	109	E	3' - 0"	7' - 0"	Privacy Hardware	without				
T.O. SLAB	109A	E	3' - 0"	7' - 0"	Lock set hardware	without				
T.O. SLAB	110	A	3' - 0"	7' - 0"	Includes Panic Hardware	1 1/2 HR Rated/ With Automatic Closing Device				
T.O. MEZANINE	110			, ,	morados i amo naraware	1 1/2 1 1/2 ( Action) Will / Action Closing Device				
T.O. MEZANINE	201	E	3' - 0"	7' - 0"	Lock set hardware	without				
Interior: 17	201	L	3-0	7 - 0	LOCK SEL HAIUWAIE	Williout				

	ROOM FINISH SCHEDULE								
						Ceiling	Wall		
Name	Number	Level	Area	Floor Finish	Base Finish	Finish	Finish		
TASTING/BAR	101	T.O. SLAB	1630 SF	Natural	4" Black Rubber Cove Base	Black Paint	Drywall/ Paint		
DRY STORAGE	102	T.O. SLAB	781 SF	Natural	4" Black Rubber Cove Base	No Paint	Drywall/ Paint		
M/RR	103	T.O. SLAB	65 SF	Sealed	4" Black Rubber Cove Base	White Paint	Tile/Paint		
W/RR	104	T.O. SLAB	65 SF	Sealed	4" Black Rubber Cove Base	White Paint	Tile/Paint		
UTL	105	T.O. SLAB	23 SF	Sealed	4" Black Rubber Cove Base	White Paint	Drywall/ Paint		
PRODUCTION	106	T.O. SLAB	1544 SF	Sealed	4" Black Rubber Cove Base	Black Paint	Drywall/ Paint		
BARREL STORAGE	107	T.O. SLAB	1195 SF	Natural	4" Black Rubber Cove Base	Black Paint	Drywall/ Paint		
BREAK ROOM	108	T.O. SLAB	204 SF	Natural	4" Black Rubber Cove Base	White Paint	Drywall/ Paint		
SHARED RR	109	T.O. SLAB	94 SF	Sealed	4" Black Rubber Cove Base	White Paint	Tile/Paint		
SPEAK EASY BAR	110	T.O. SLAB	894 SF	Natural	4" Black Rubber Cove Base	Black Paint	Drywall/ Paint		
RETAIL	111	T.O. SLAB	100 SF	Sealed	4" Black Rubber Cove Base	Black Paint	Drywall/ Paint		
BOILER ROOM	112	T.O. SLAB	108 SF	Natural	4" Black Rubber Cove Base	Black Paint	N/A		
OUTDOOR PATIO	113	T.O. SLAB	467 SF	No Work	N/A	N/A	N/A		
T.O. SLAB: 13							,		
OFFICE	201	T.O. MEZZANINE	204 SF	Carpet Tile Optional	4" Black Rubber Cove Base	Black Paint	Drywall/ Pain		
T.O. MEZZANINE: 1				,		,			
Grand total: 14									

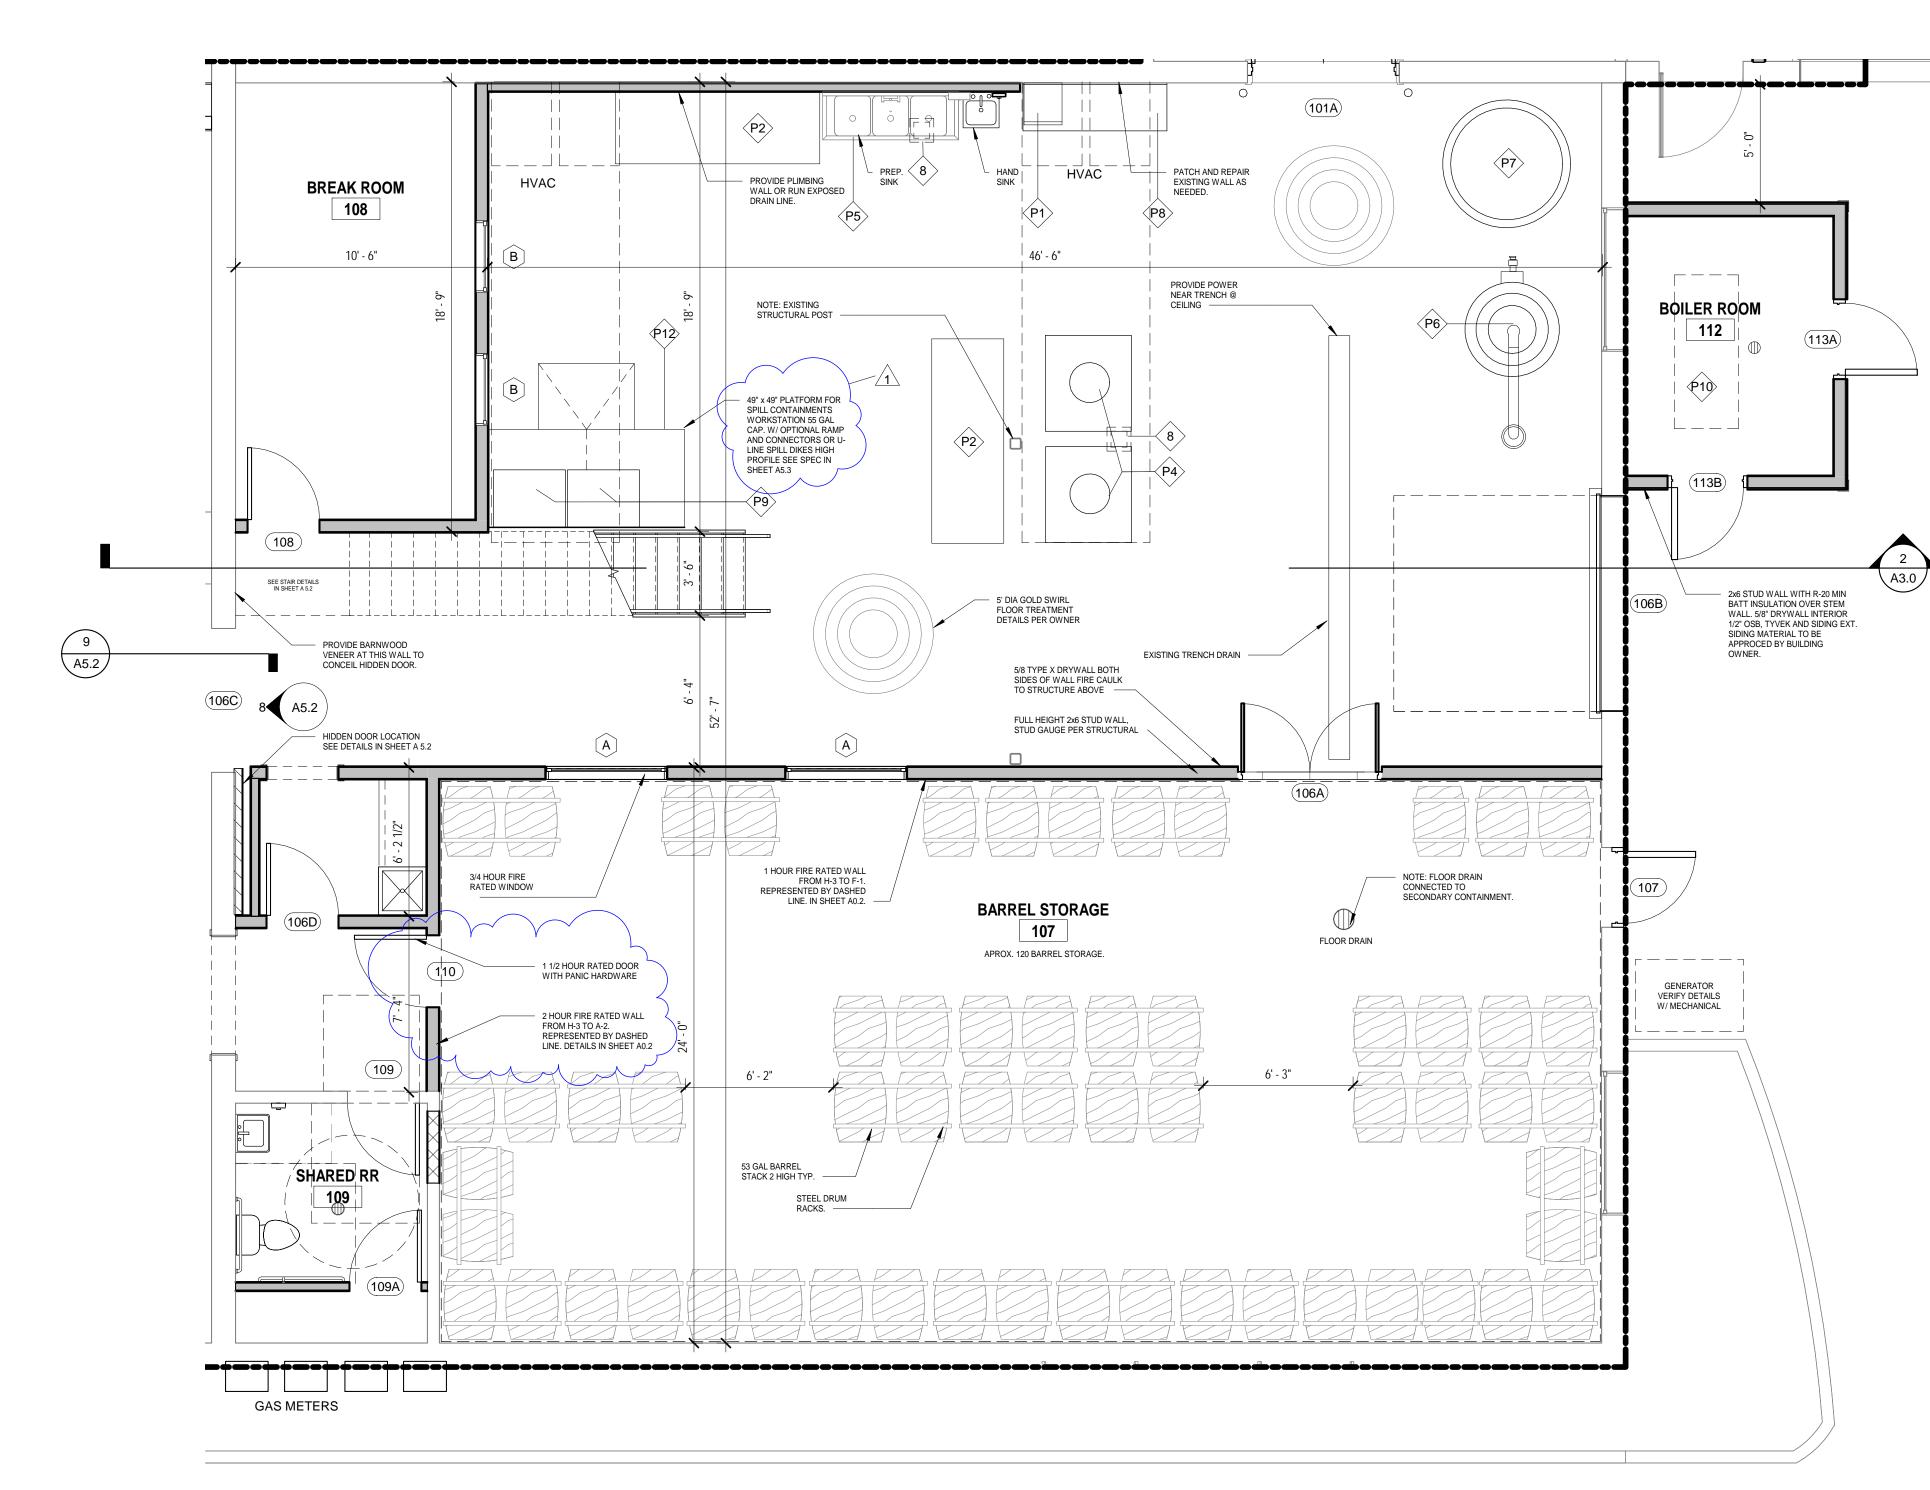

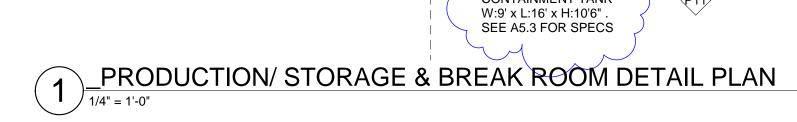



PRECAST SECONDARY CONTAINMENT TANK

	EQUIPMENT SCHEDULE								
ITEM NUM.	EQUIPMENT NAME	QTY.	MODEL NAME/NUMBER	EQUIPMENT SIZE	MOUNTING	POWER REQ.	GAS REQ.	WATER REQ.	NOTES
P1	- YEAST REFRIGERATOR	1	- GME04GGKBB - 19	9 5/8"W x 21 1/4"D x 34 7/8"H	- FLOOR	- 120 V, 10 A	- N/A	- NONE	
P2	- PALLET RACKS	1	- PROVIDED BY OWNER - 8'\	W x 3'D x 8'H	- FLOOR	- N/A	- N/A	- NONE	
P4	- FERMENT TANKS	1	- REGENCY / 600S1181818XRT - 44	4 1/2"W x 43 3/4"D x 29 1/2" H	- FLOOR	- N/A	- N/A	- FILTERED	
P5	- 3 COMP. PREP. SINK	1	- REGENCY/ 600S3162018G - 88	8"W x 25.5" D x 36.5" H	- FLOOR	- N/A	- N/A	-TAP	
P6	- STILL 230 gal	1	- DYE-500L-POTSILL COPPER STILL	s' W x 4.25' D x 9'10" H	- FLOOR	- N/A		-TAP	
P7	- COOK TANK 500 gal	1	- DYE-500GALLON MASH TUN - 69	5" DIA x 99"	- FLOOR				
P8	- STAINLESS TABLE	1	- REGENCY OR EQUAL - 72	2"W x 24" D x 38"H	- FLOOR	- N/A	- N/A	- NONE	
P9	- BOTTLING	2	- VERIFY DETAILS W/ OWNER		- FLOOR	- N/A	- N/A	- NONE	
P10	- BOILER	1	- RITE 135 S - 71	1"W x 32" D x 63"H	- FLOOR	- 120V, 8 A	- YES, 1 1/4"	-TAP 1 1/2"	1,080,000 BTU OUTPUT
P11	- SEPTIC TANK	1	- CST-10000 - 16	6'W x 9' D x 10'6"H	- UNDER GROUND	- 120V, 8 A	- N/A	- NONE	10,000 GAL.
P12	- SPILL CONTAINMENT DRUM	2	- 4 DRI IM- H4037 OR H-8678	9"W x 49"D x 6"H 0"W x 4"D x 4 1/2"H	- FLOOR	- N/A	- N/A	- NONE	- CAP. 49 GAL. ADD 33"x48" RAMP - U-LINE HIGH PROFILE MODEL



Approved January 11, 2022 © ASHER ARCHITECTS B.CORP. ALL RIGHTS RESERVED. This drawing is an instrument of Asher Architects. Use of this whole or in part without written

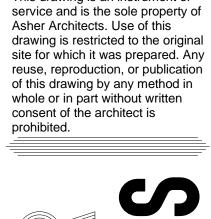

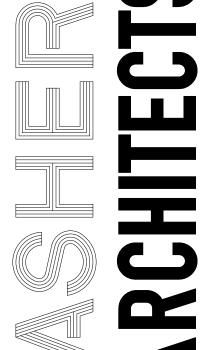



a: 512 5th St. BERTHOUD CO. 80513 p: 970-532-9970


w. AsherArch.com e: David@AsherArch.com




PROJECT INFORMATION: DOCUMENT DATE: 1/12/2022 2:49:25 PM DOCUMENT PHASE: CONSTRUCTION DOCUMENTS

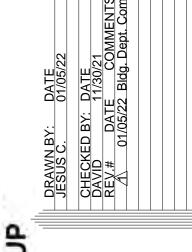

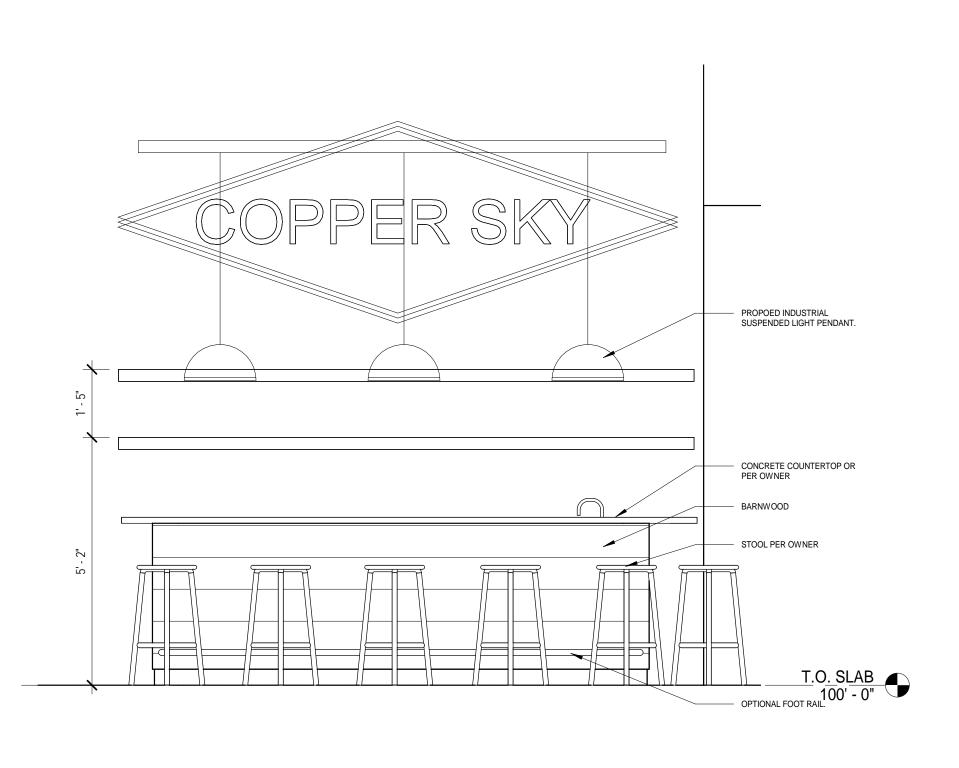

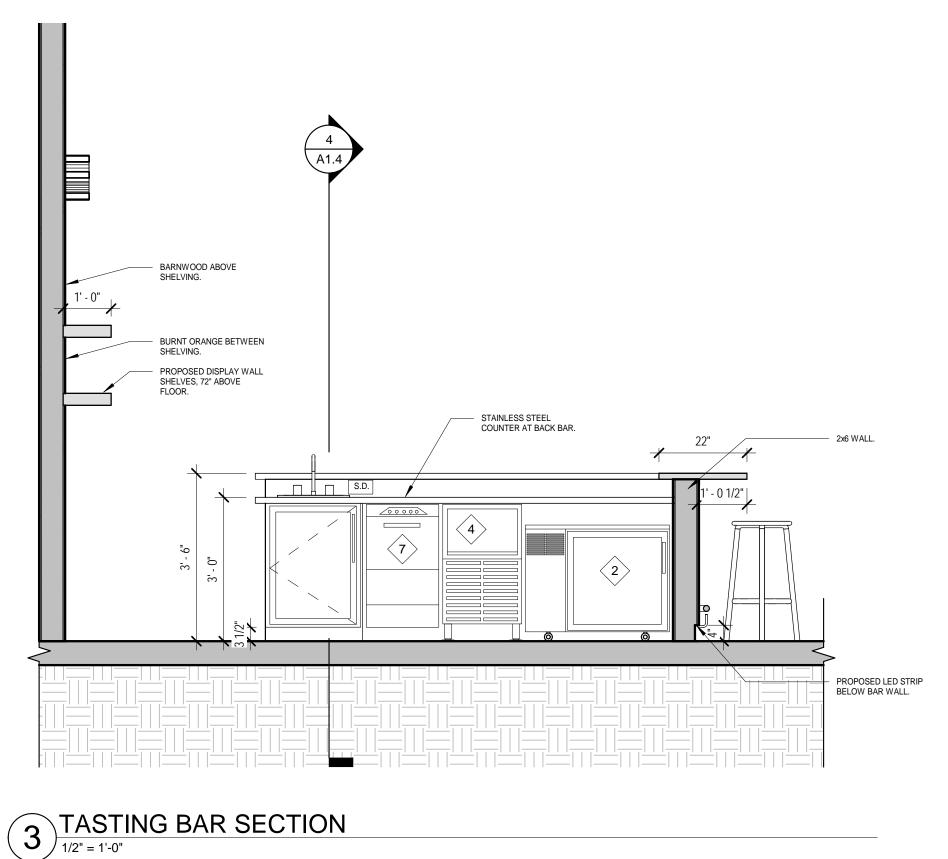

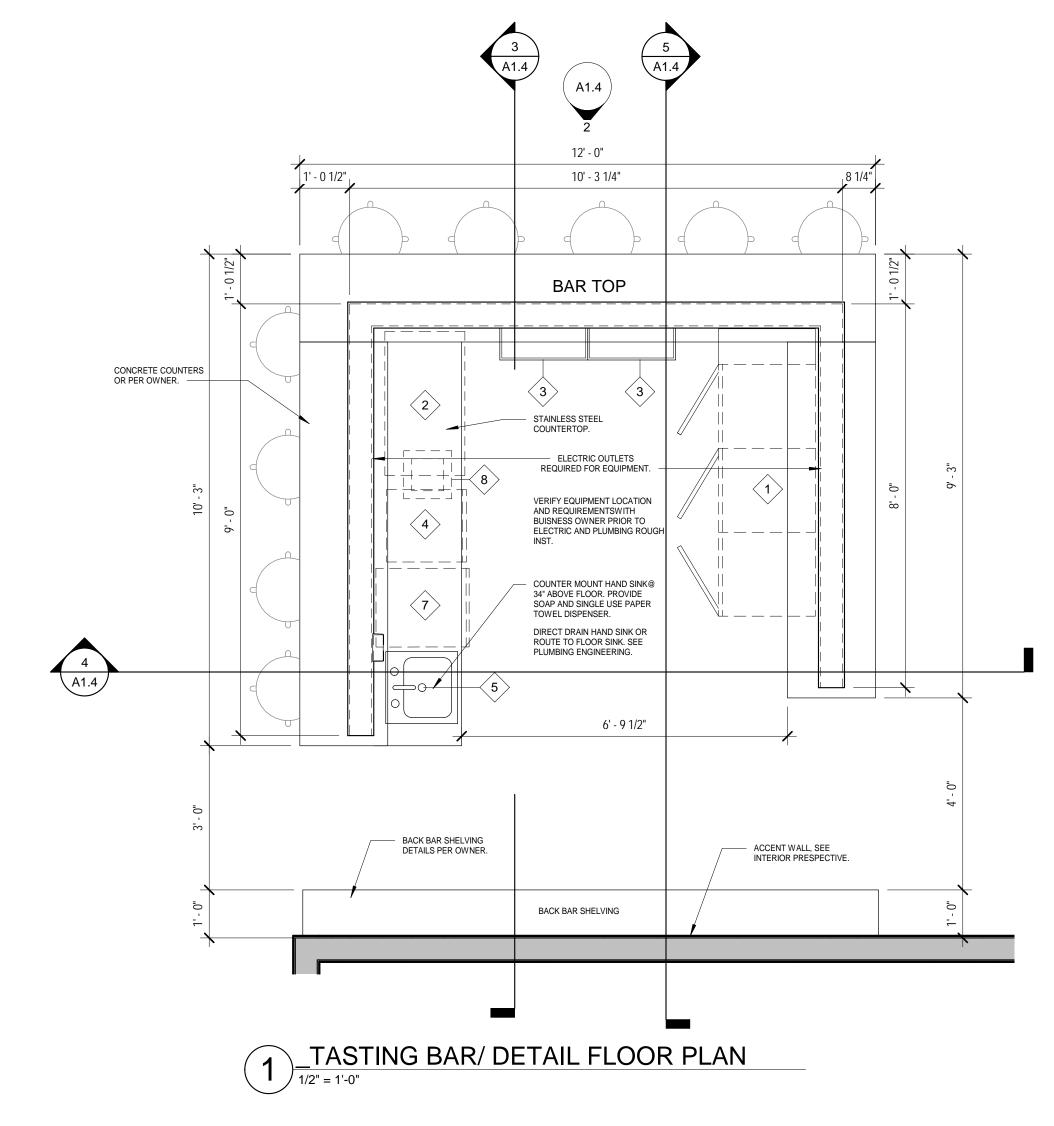



© ASHER ARCHITECTS B.CORP. ALL RIGHTS RESERVED. This drawing is an instrument of service and is the sole property of Asher Architects. Use of this drawing is restricted to the original site for which it was prepared. Any reuse, reproduction, or publication of this drawing by any method in whole or in part without written consent of the architect is prohibited.




a: 512 5th St. BERTHOUD CO. 80513 p: 970-532-9970

w. AsherArch.com e: David@AsherArch.com

FOR CONSTRUCTION




PROJECT INFORMATION: DOCUMENT DATE: 1/12/2022 2:49:29 PM DOCUMENT PHASE: CONSTRUCTION DOCUMENTS

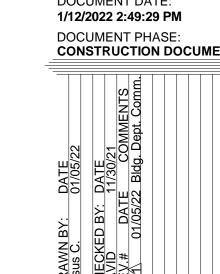


**BAR EQUIPMENT** (ALL EQUIPMENT TO BE VERIFIED BY OWNER) ITEM NUM. QTY. | MODEL NAME/NUMBER **EQUIPMENT NAME EQUIPMENT SIZE** MOUNTING VOLTAGE **NOTES** - BAR REF. - 3 SWING DOOR - TRUE/ TBB-24GAL-72G - FLOOR - 71.88"W x 24.25"D x 34.25"H - 120/ 8A - S.S. TOP W/BACKSPLASH - GLASTENDER/ LP36-IBS - BAR COOLER - 36"W x 20"D x 30"H - FLOOR - 120/ 8A - DOUBLE TIER SPEED RAIL - TBD-2SBD-N6 - 22"W x 8 1/8"D x 9 1/2"H - WALL - ICE MAKER MACHINE - #194UC120A - FLOOR - 120/11A · 19.7"W x23.3"D x 35.5"H - REGENCY/ 600HS12SP - COUNTER - HAND WASH SINK - 12"W x 16" D - LOCKER STORAGE - VERIFY DETAILS W/ OWNER | - 12"W x 12" D - FLOOR - LOCATE PER OWNER - DISH WASHER - MOTAK/DSP3 - 18.11"W x 19.92" D x 30.71" H | - FLOOR - OWNED - 208 - FLOOR SINK 3 - ZURN FD2375-NH3-H - 12"W x 12" D - FLOOR


ROOM FINISH SCHEDULE									
						Ceiling	Wall		
Name	Number	Level	Area	Floor Finish	Base Finish	Finish	Finish		
TASTING/BAR	101	T.O. SLAB	1630 SF	Natural	4" Black Rubber Cove Base	Black Paint	Drywall/ Paint		
DRY STORAGE	102	T.O. SLAB	781 SF	Natural	4" Black Rubber Cove Base	No Paint	Drywall/ Paint		
M/RR	103	T.O. SLAB	65 SF	Sealed	4" Black Rubber Cove Base	White Paint	Tile/Paint		
W/RR	104	T.O. SLAB	65 SF	Sealed	4" Black Rubber Cove Base	White Paint	Tile/Paint		
UTL	105	T.O. SLAB	23 SF	Sealed	4" Black Rubber Cove Base	White Paint	Drywall/ Paint		
PRODUCTION	106	T.O. SLAB	1544 SF	Sealed	4" Black Rubber Cove Base	Black Paint	Drywall/ Pain		
BARREL STORAGE	107	T.O. SLAB	1195 SF	Natural	4" Black Rubber Cove Base	Black Paint	Drywall/ Pain		
BREAK ROOM	108	T.O. SLAB	204 SF	Natural	4" Black Rubber Cove Base	White Paint	Drywall/ Pain		
SHARED RR	109	T.O. SLAB	94 SF	Sealed	4" Black Rubber Cove Base	White Paint	Tile/Paint		
SPEAK EASY BAR	110	T.O. SLAB	894 SF	Natural	4" Black Rubber Cove Base	Black Paint	Drywall/ Paint		
RETAIL	111	T.O. SLAB	100 SF	Sealed	4" Black Rubber Cove Base	Black Paint	Drywall/ Pain		
BOILER ROOM	112	T.O. SLAB	108 SF	Natural	4" Black Rubber Cove Base	Black Paint	N/A		
OUTDOOR PATIO	113	T.O. SLAB	467 SF	No Work	N/A	N/A	N/A		
T.O. SLAB: 13	•								
OFFICE	201	T.O. MEZZANINE	204 SF	Carpet Tile Optional	4" Black Rubber Cove Base	Black Paint	Drywall/ Pain		
T.O. MEZZANINE: 1									
Grand total: 14									

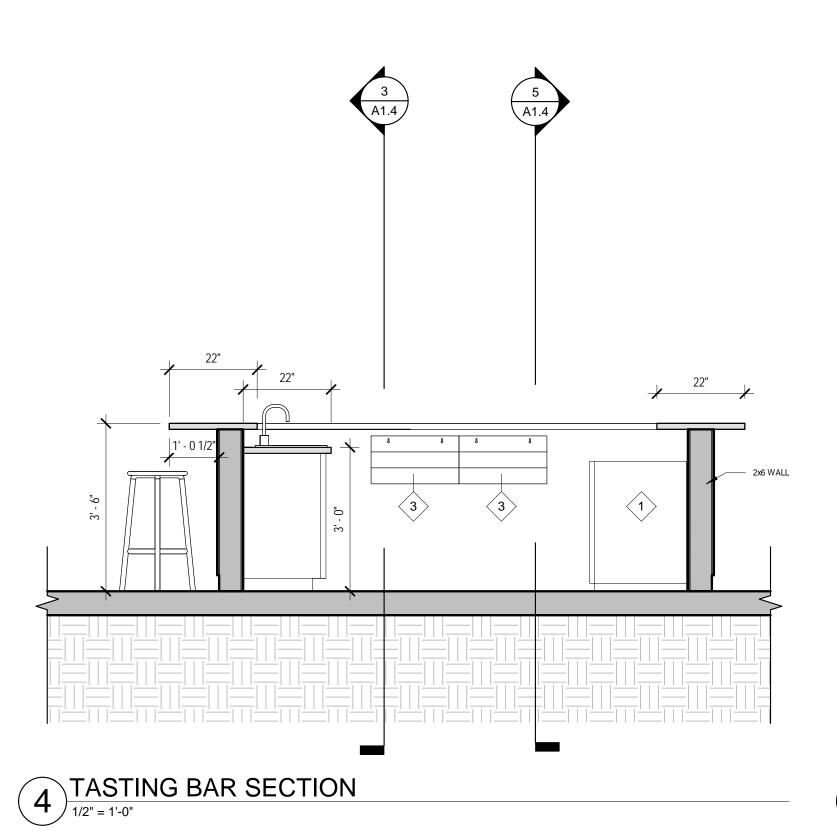



TASTING BAR ELEVATION


1/2" = 1'-0"

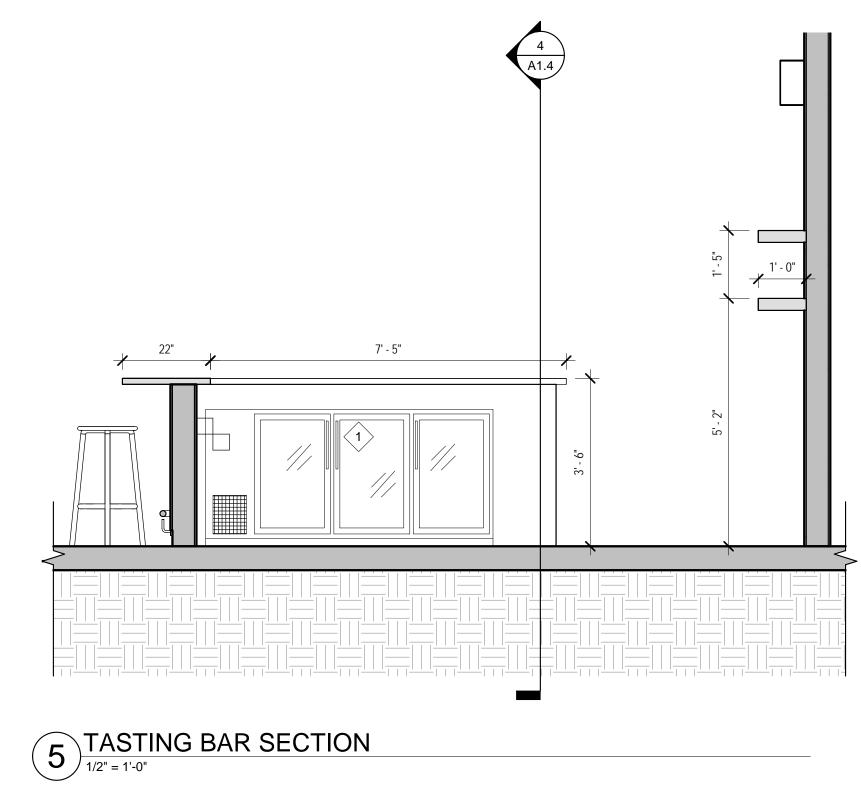

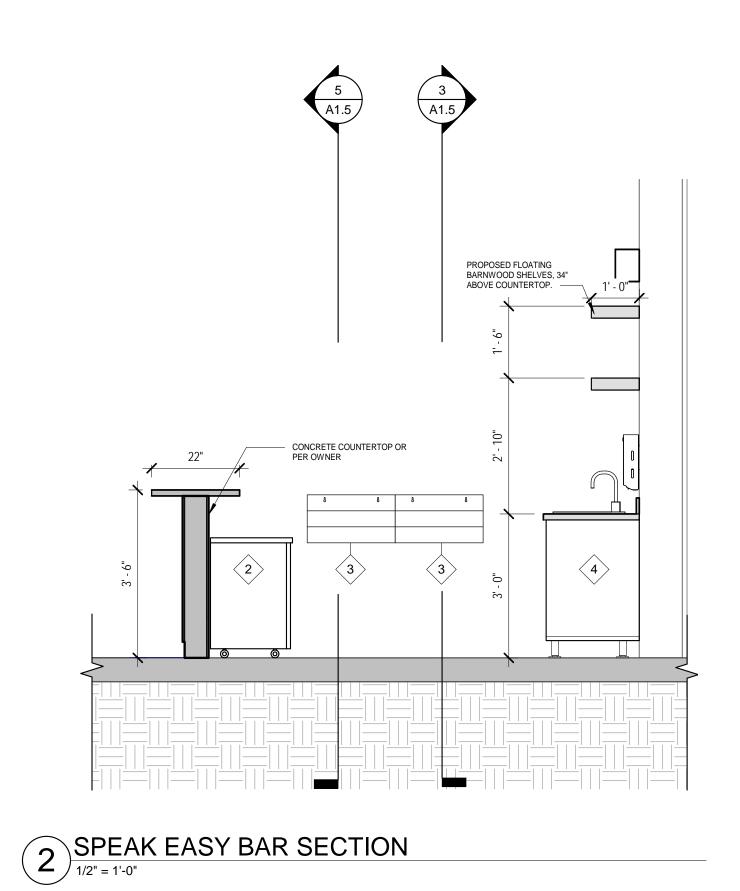

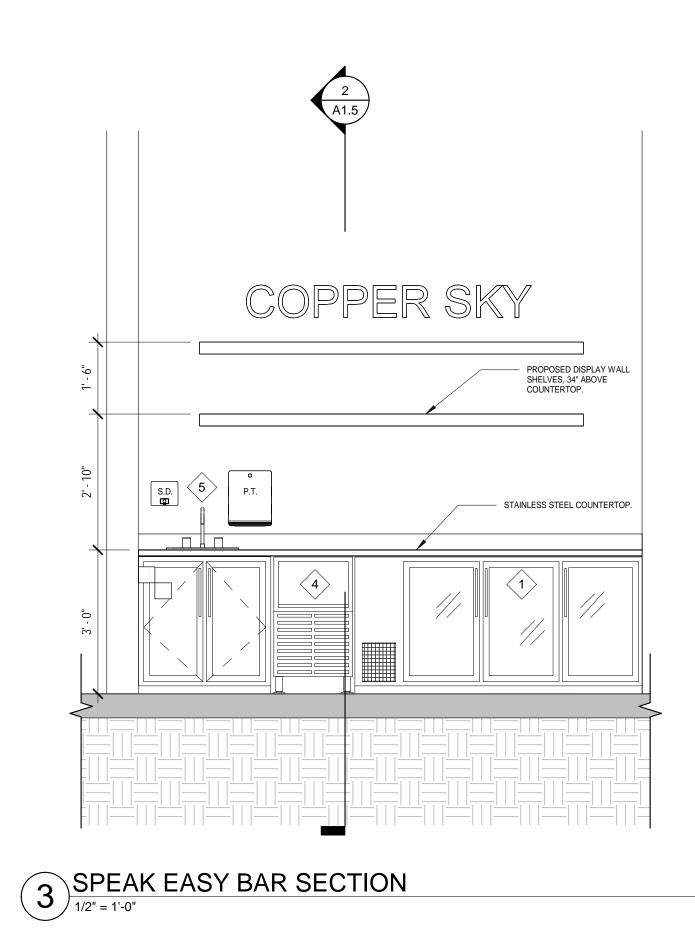

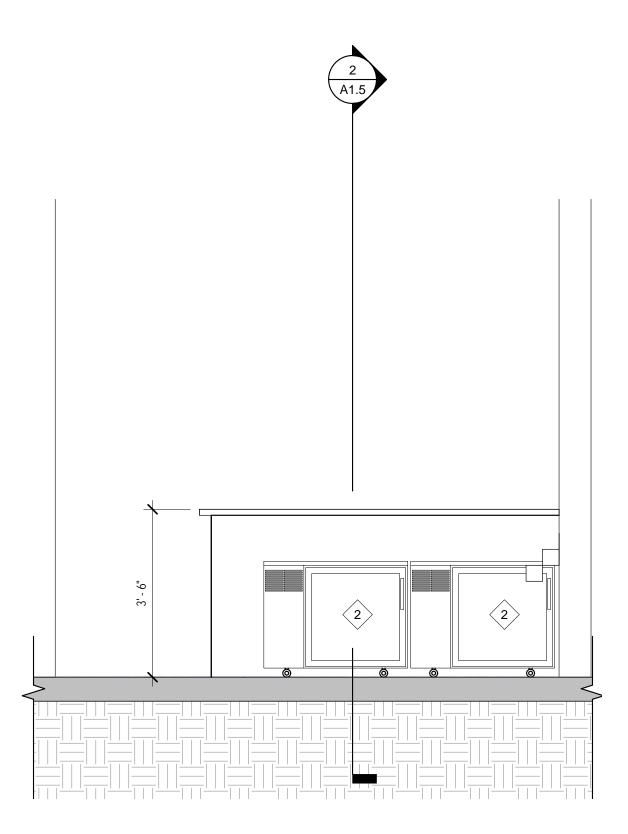


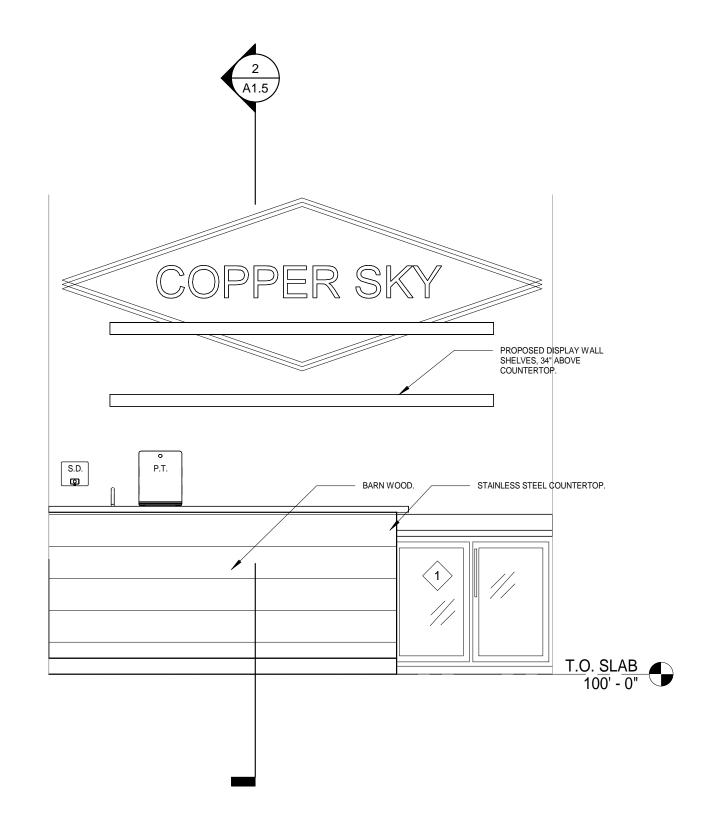

5 SPEAK EASY BAR SECTION


1/2" = 1'-0"



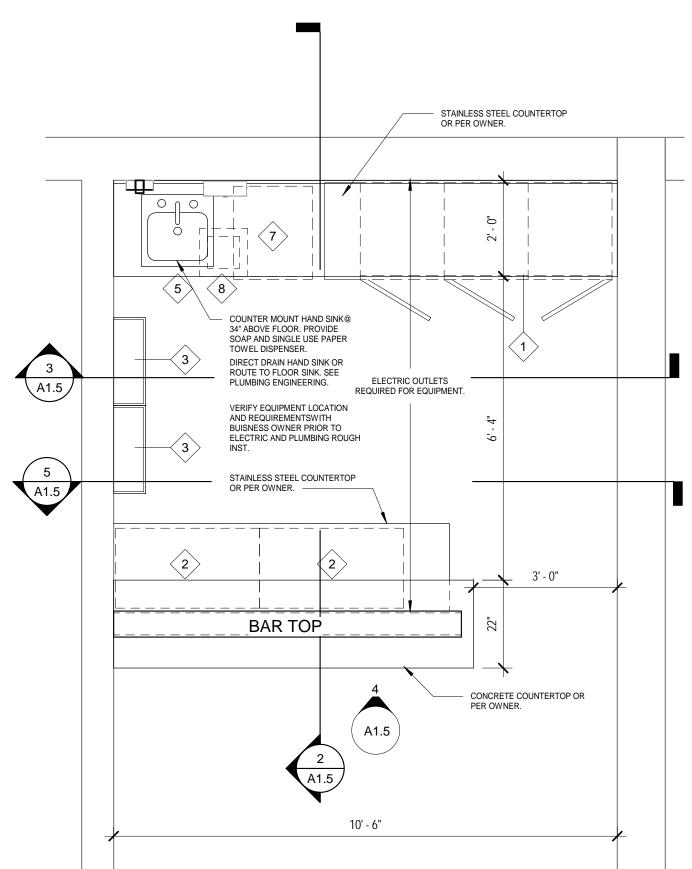



		STAINL OR PE	LESS STEEL COUNTERTOP R OWNER.
	COUNTER MOUNT HAND 34" ABOVE FLOOR. PRO SOAP AND SINGLE USE TOWEL DISPENSER.	VIDE	5,-0,
3	DIRECT DRAIN HAND SII ROUTE TO FLOOR SINK PLUMBING ENGINEERIN	. SEE	
A1.5	VERIFY EQUIPMENT LOWAND REQUIREMENTSW. BUISNESS OWNER PRICE ELECTRIC AND PLUMBININST.	REQUIRED FOR EQUIPMENT.  CATION ITH OR TO	.4 - 4"
A1.5	STAINLESS STEEL COUL OR PER OWNER.	NTERTOP	
▼	2	2	3' - 0"
<u> </u>	BAR TOP	<u>                                     </u>	52
		4	CONCRETE COUNTERTOP OR PER OWNER.
	A1		
		10' - 6"	

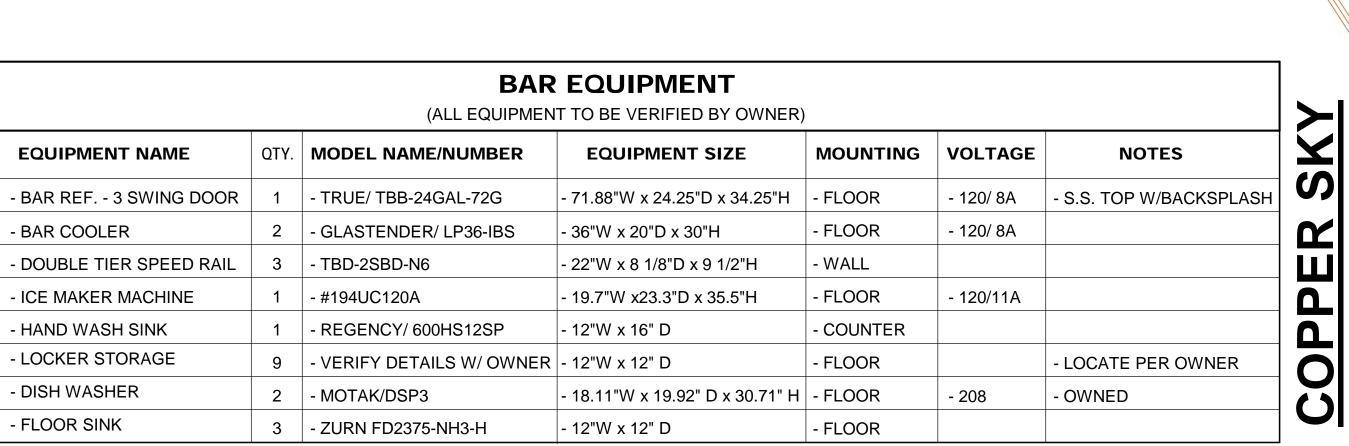

ROOM FINISH SCHEDULE									
						Ceiling	Wall		
Name	Number	Level	Area	Floor Finish	Base Finish	Finish	Finish		
TASTING/BAR	101	T.O. SLAB	1630 SF	Natural	4" Black Rubber Cove Base	Black Paint	Drywall/ Pain		
DRY STORAGE	102	T.O. SLAB	781 SF	Natural	4" Black Rubber Cove Base	No Paint	Drywall/ Pain		
M/RR	103	T.O. SLAB	65 SF	Sealed	4" Black Rubber Cove Base	White Paint	Tile/Paint		
W/RR	104	T.O. SLAB	65 SF	Sealed	4" Black Rubber Cove Base	White Paint	Tile/Paint		
UTL	105	T.O. SLAB	23 SF	Sealed	4" Black Rubber Cove Base	White Paint	Drywall/ Pain		
PRODUCTION	106	T.O. SLAB	1544 SF	Sealed	4" Black Rubber Cove Base	Black Paint	Drywall/ Pain		
BARREL STORAGE	107	T.O. SLAB	1195 SF	Natural	4" Black Rubber Cove Base	Black Paint	Drywall/ Pain		
BREAK ROOM	108	T.O. SLAB	204 SF	Natural	4" Black Rubber Cove Base	White Paint	Drywall/ Pain		
SHARED RR	109	T.O. SLAB	94 SF	Sealed	4" Black Rubber Cove Base	White Paint	Tile/Paint		
SPEAK EASY BAR	110	T.O. SLAB	894 SF	Natural	4" Black Rubber Cove Base	Black Paint	Drywall/ Pain		
RETAIL	111	T.O. SLAB	100 SF	Sealed	4" Black Rubber Cove Base	Black Paint	Drywall/ Pain		
BOILER ROOM	112	T.O. SLAB	108 SF	Natural	4" Black Rubber Cove Base	Black Paint	N/A		
OUTDOOR PATIO	113	T.O. SLAB	467 SF	No Work	N/A	N/A	N/A		
T.O. SLAB: 13									
OFFICE	201	T.O. MEZZANINE	204 SF	Carpet Tile Optional	4" Black Rubber Cove Base	Black Paint	Drywall/ Pain		


ITEM NUM.

2

NOTE: PROVIDE BID ALTERNATE TO PROVIDE STAINED AND SPLIP RESISTANCE CLEAR COAT OVER CONCRETE FLOOR WITHIN TASTING ROOM AND SPEAKEASY. BASE BID TO BE NO WORK TO EXISTING CONCRETE FLOORS WHERE NATURAL FLOOR FINISH IS NOTED.



© ASHER ARCHITECTS B.CORP. ALL RIGHTS RESERVED. This drawing is an instrument of service and is the sole property of Asher Architects. Use of this drawing is restricted to the original site for which it was prepared. Any reuse, reproduction, or publication of this drawing by any method in whole or in part without written consent of the architect is prohibited.

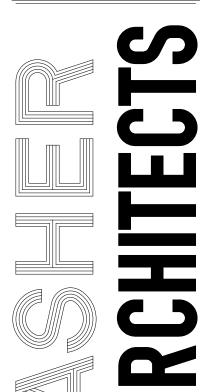

a: 512 5th St. BERTHOUD CO. 80513 p: 970-532-9970


w. AsherArch.com e: David@AsherArch.com

FOR CONSTRUCTION



PROJECT INFORMATION: 21-C26 DOCUMENT DATE: 1/12/2022 2:49:30 PM DOCUMENT PHASE: CONSTRUCTION DOCUMENTS

BULDERS DETAIL SPEAK EASY BAR

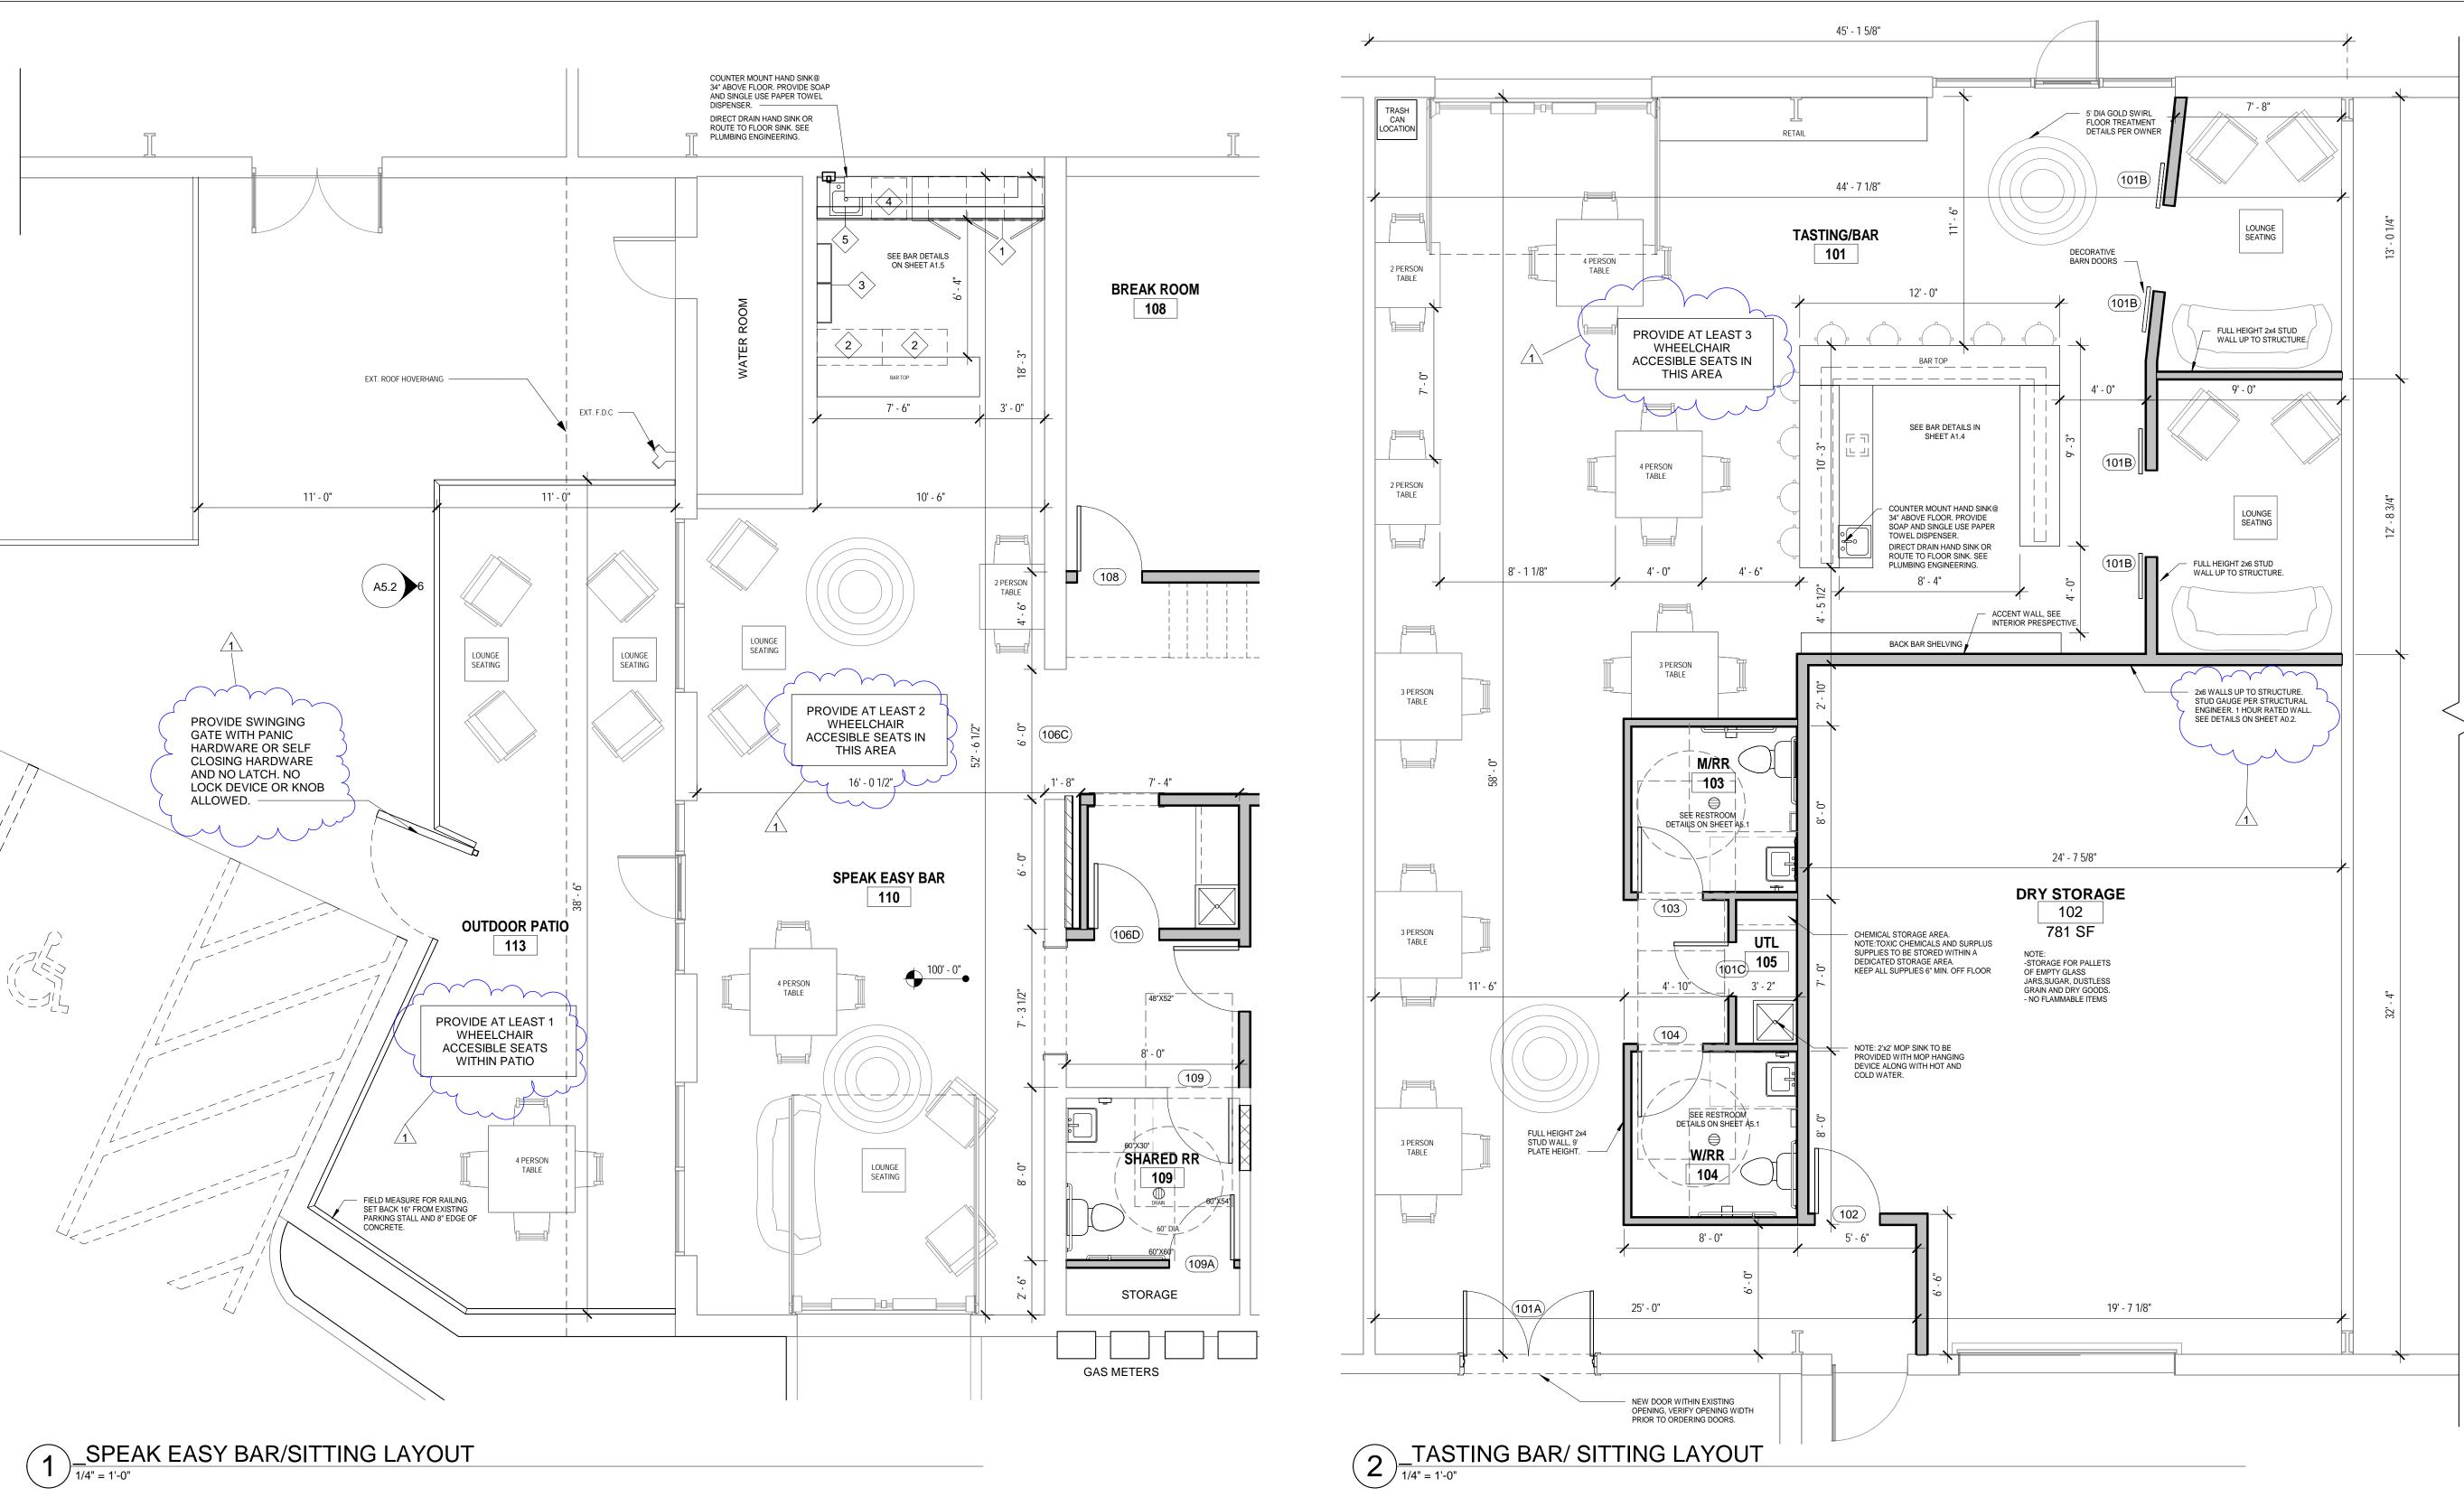

1 SPEAK EASY BAR/SITTING LAYOUT


DOOR SCHEDULE									
Level	Mark	Type Comments	Width	Height	Comments	Fire Rating			
Exterior T.O. SLAB									
T.O. SLAB	106B	В	9' - 0"	9' - 0"	Provide Electric Opener	without			
T.O. SLAB	107	A	3' - 0"	7' - 0"	Includes Panic Hardware	3/4 HR Rated/ With Automatic Closing Device			
T.O. SLAB	113A	A	3' - 0"	7' - 0"	Lock set hardware	3/4 HR Rated/ With Automatic Closing Device			
T.O. SLAB	113B	A	3' - 0"	7' - 0"	Lock set hardware	3/4 HR Rated/ With Automatic Closing Device			
Exterior: 4 Interior T.O. SLAB									
T.O. SLAB	101A	D	6' - 0"	8' - 0"	Electronic Keypad	without			
T.O. SLAB	101B	F	2' - 0"	8' - 0"	Black Barn Door Hardware	without			
T.O. SLAB	101B	F	2' - 0"	8' - 0"	Black Barn Door Hardware	without			
T.O. SLAB	101B	F	2' - 0"	8' - 0"	Black Barn Door Hardware	without			
T.O. SLAB	101B	F	2' - 0"	8' - 0"	Black Barn Door Hardware	without			
T.O. SLAB	101C	E	2' - 6"	7' - 0"	Lock set hardware	without			
T.O. SLAB	102	E	3' - 0"	7' - 0"	Electronic Keypad	without			
	103	E	3' - 0"	7' - 0"	Privacy Hardware	without			
T.O. SLAB				71 01	D: 11 1	***			
	104	E	3' - 0"	7' - 0"	Privacy Hardware	without			
T.O. SLAB	104 106A	E C	3' - 0" 6' - 0"	7' - 0" 8' - 0"	Includes Panic Hardware				
T.O. SLAB T.O. SLAB		C G			1 -				
T.O. SLAB T.O. SLAB T.O. SLAB	106A	С	6' - 0"	8' - 0"	Includes Panic Hardware	3/4 HR Rated/ With Automatic Closing Device			
T.O. SLAB T.O. SLAB T.O. SLAB T.O. SLAB	106A 106C	C G E E	6' - 0" 6' - 0"	8' - 0" 8' - 0"	Includes Panic Hardware Passage Hardware	3/4 HR Rated/ With Automatic Closing Device without			
T.O. SLAB T.O. SLAB T.O. SLAB T.O. SLAB T.O. SLAB	106A 106C 106D	C G E E	6' - 0" 6' - 0" 3' - 0"	8' - 0" 8' - 0" 7' - 0"	Includes Panic Hardware Passage Hardware Passage Hardware	3/4 HR Rated/ With Automatic Closing Device without without			
T.O. SLAB	106A 106C 106D 108	C G E E	6' - 0" 6' - 0" 3' - 0" 3' - 0"	8' - 0" 8' - 0" 7' - 0" 7' - 0"	Includes Panic Hardware Passage Hardware Passage Hardware Passage Hardware	3/4 HR Rated/ With Automatic Closing Device without without without			
T.O. SLAB	106A 106C 106D 108 109	C G E E	6' - 0" 6' - 0" 3' - 0" 3' - 0"	8' - 0" 8' - 0" 7' - 0" 7' - 0"	Includes Panic Hardware Passage Hardware Passage Hardware Passage Hardware Privacy Hardware	3/4 HR Rated/ With Automatic Closing Device without without without without without			
T.O. SLAB	106A 106C 106D 108 109 109A	C G E E E	6' - 0" 6' - 0" 3' - 0" 3' - 0" 3' - 0"	8' - 0" 8' - 0" 7' - 0" 7' - 0" 7' - 0"	Includes Panic Hardware Passage Hardware Passage Hardware Passage Hardware Privacy Hardware Lock set hardware	3/4 HR Rated/ With Automatic Closing Device without without without without without without without			

WINDOW SCHEDULE									
				-					
TAG	Туре	COUNT	WIDTH	HEIGHT	COMMENTS				
A	FXD	2	5' - 0"	5' - 0"	3/4 hr Rated Fire Window				
В	FXD	4	3' - 0"	3' - 0"					
	A	TAG Type	TAG Type COUNT  A FXD 2	TAG Type COUNT WIDTH  A FXD 2 5'-0"	TAG         Type         COUNT         WIDTH         HEIGHT           A         FXD         2         5' - 0"         5' - 0"				

				FINISH SCH			
						Ceiling	Wall
Name	Number	Level	Area	Floor Finish	Base Finish	Finish	Finish
TASTING/BAR	101	T.O. SLAB	1630 SF	Natural	4" Black Rubber Cove Base	Black Paint	Drywall/ Paint
DRY STORAGE	102	T.O. SLAB	781 SF	Natural	4" Black Rubber Cove Base	No Paint	Drywall/ Paint
M/RR	103	T.O. SLAB	65 SF	Sealed	4" Black Rubber Cove Base	White Paint	Tile/Paint
W/RR	104	T.O. SLAB	65 SF	Sealed	4" Black Rubber Cove Base	White Paint	Tile/Paint
JTL	105	T.O. SLAB	23 SF	Sealed	4" Black Rubber Cove Base	White Paint	Drywall/ Paint
PRODUCTION	106	T.O. SLAB	1544 SF	Sealed	4" Black Rubber Cove Base	Black Paint	Drywall/ Paint
BARREL STORAGE	107	T.O. SLAB	1195 SF	Natural	4" Black Rubber Cove Base	Black Paint	Drywall/ Paint
BREAK ROOM	108	T.O. SLAB	204 SF	Natural	4" Black Rubber Cove Base	White Paint	Drywall/ Paint
SHARED RR	109	T.O. SLAB	94 SF	Sealed	4" Black Rubber Cove Base	White Paint	Tile/Paint
SPEAK EASY BAR	110	T.O. SLAB	894 SF	Natural	4" Black Rubber Cove Base	Black Paint	Drywall/ Paint
RETAIL	111	T.O. SLAB	100 SF	Sealed	4" Black Rubber Cove Base	Black Paint	Drywall/ Paint
BOILER ROOM	112	T.O. SLAB	108 SF	Natural	4" Black Rubber Cove Base	Black Paint	N/A
OUTDOOR PATIO	113	T.O. SLAB	467 SF	No Work	N/A	N/A	N/A
T.O. SLAB: 13		1	<u>'</u>				
OFFICE	201	T.O. MEZZANINE	204 SF	Carpet Tile Optional	4" Black Rubber Cove Base	Black Paint	Drywall/ Pain



© ASHER ARCHITECTS B.CORP. ALL RIGHTS RESERVED. This drawing is an instrument of service and is the sole property of Asher Architects. Use of this drawing is restricted to the original site for which it was prepared. Any reuse, reproduction, or publication of this drawing by any method in whole or in part without written consent of the architect is prohibited.

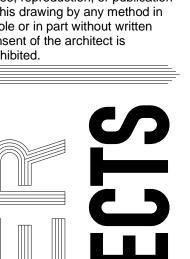




a: 512 5th St. BERTHOUD CO. 80513 p: 970-532-9970 w. AsherArch.com


e: David@AsherArch.com



PROJECT INFORMATION: 21-C26 DOCUMENT DATE: 1/12/2022 2:49:33 PM DOCUMENT PHASE: CONSTRUCTION DOCUMENTS

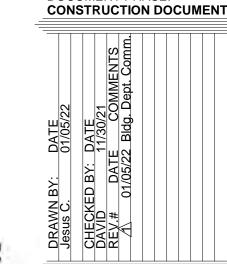

FURNITURE DETAIL

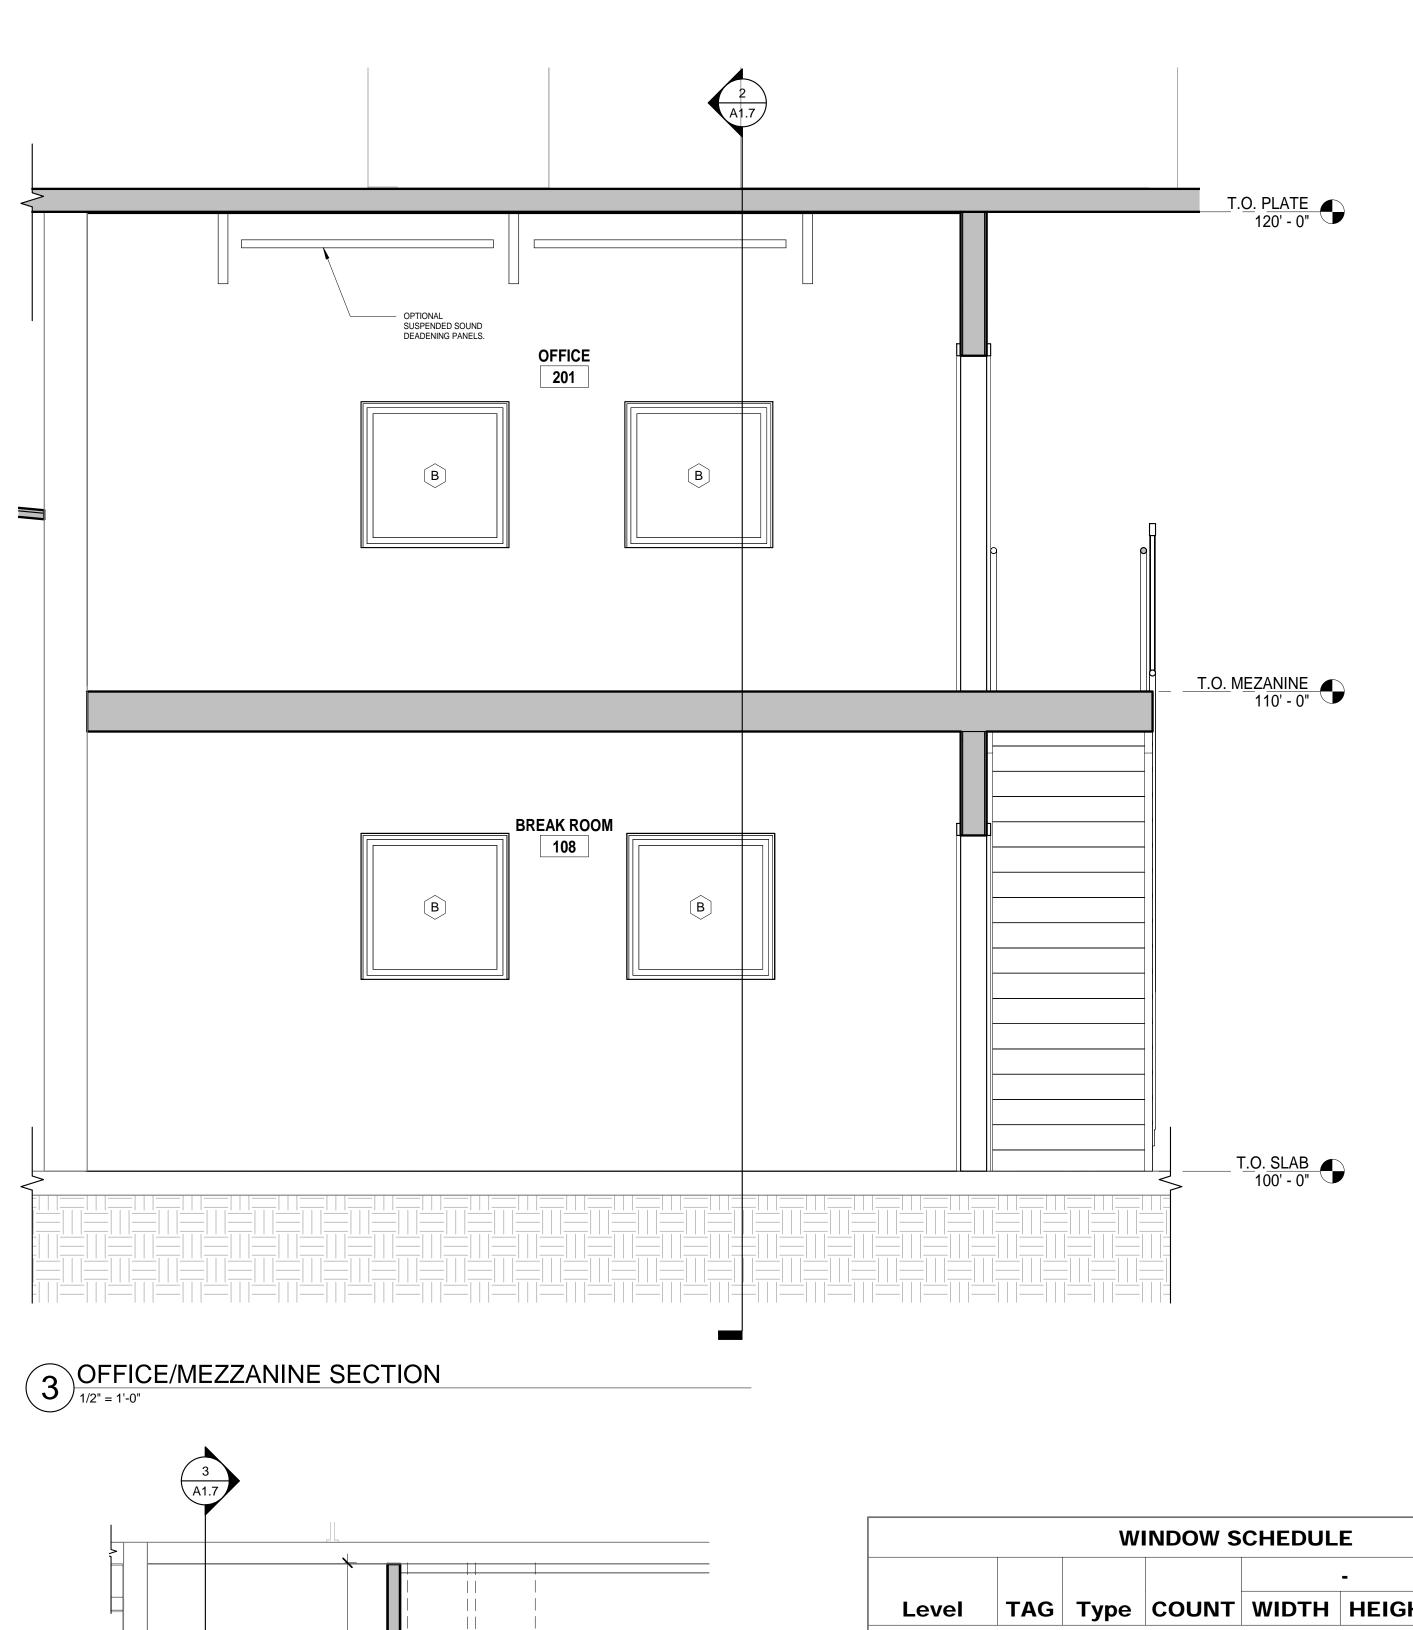

EXISTING HVAC

10' - 10"

OFFICE

201

10' - 6"

1 PROPOSED OFFICE/MEZZANINE DETAIL PLAN

SEE STAIR DETAILS DN-


A1.7


T.O. SLAB


Grand total: 6

<varies>

A FXD

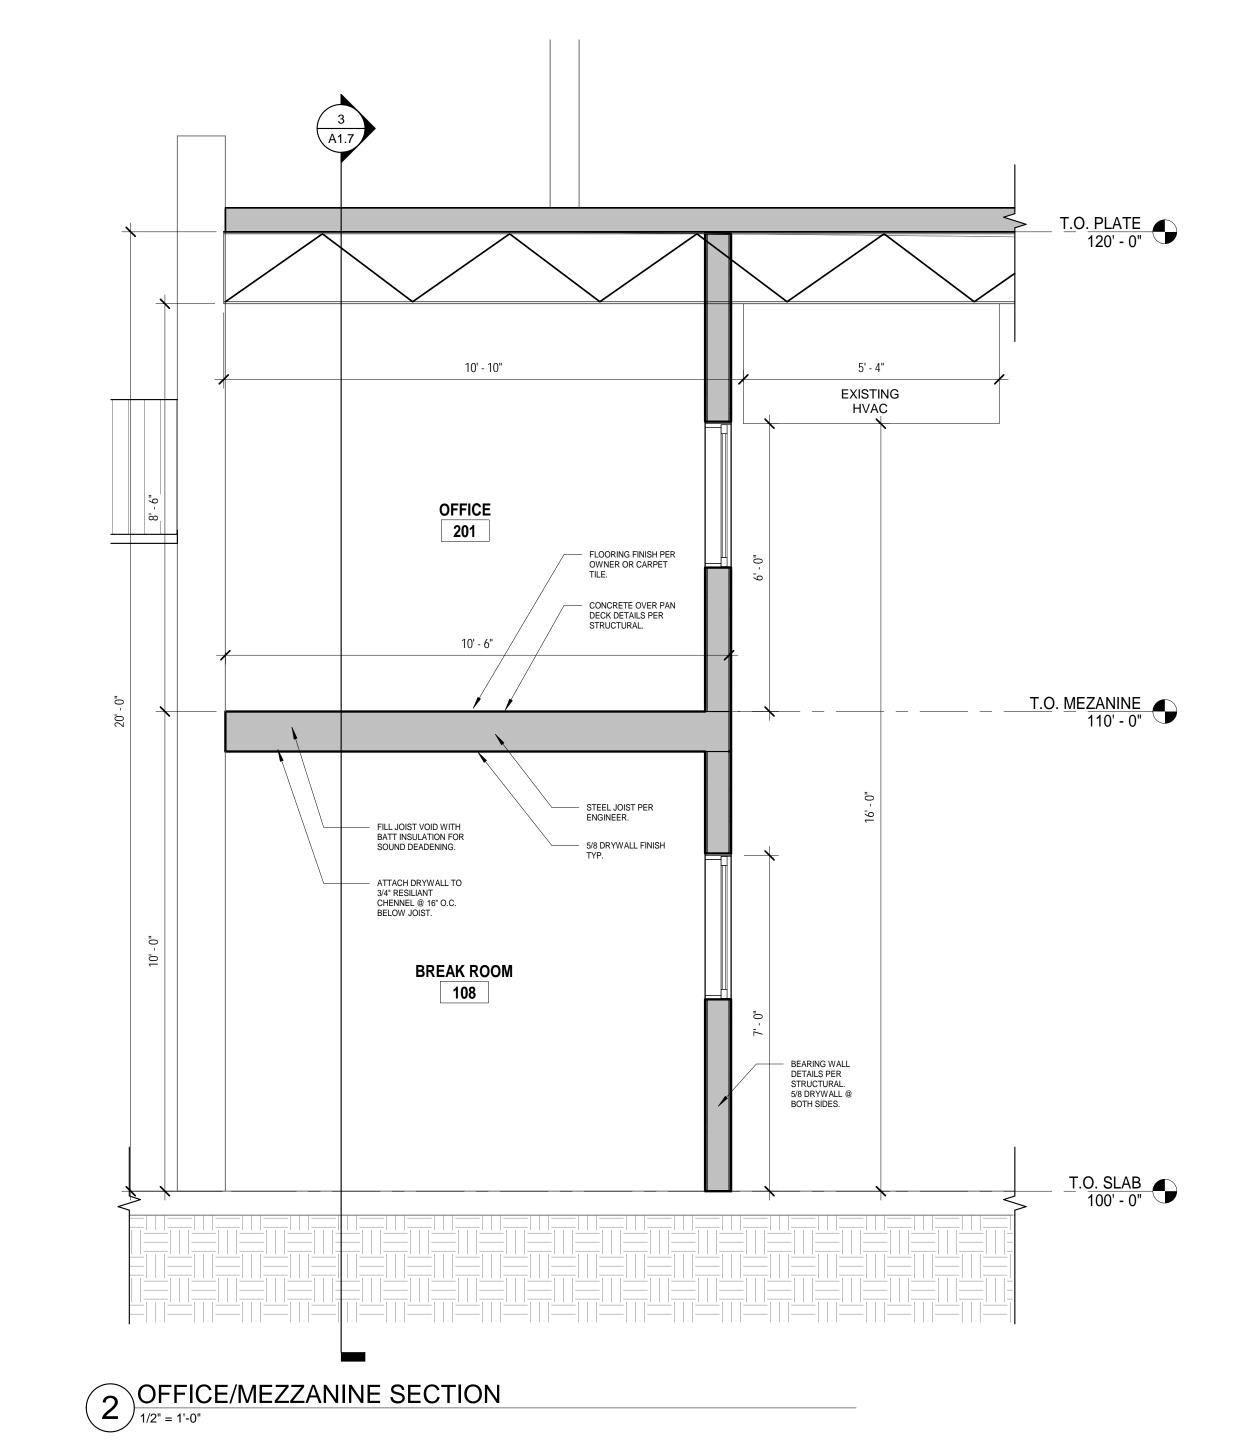

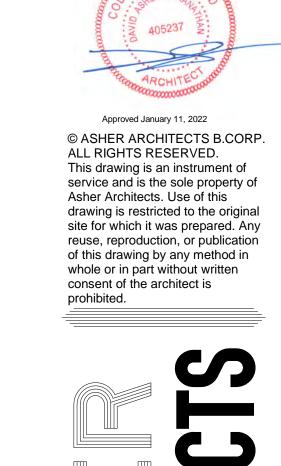

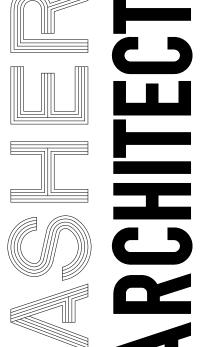


a: 512 5th St. BERTHOUD CO. 80513 p: 970-532-9970 w. AsherArch.com


e: David@AsherArch.com




PROJECT INFORMATION: DOCUMENT DATE: 1/12/2022 2:49:34 PM DOCUMENT PHASE: CONSTRUCTION DOCUMENTS

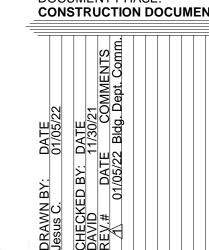



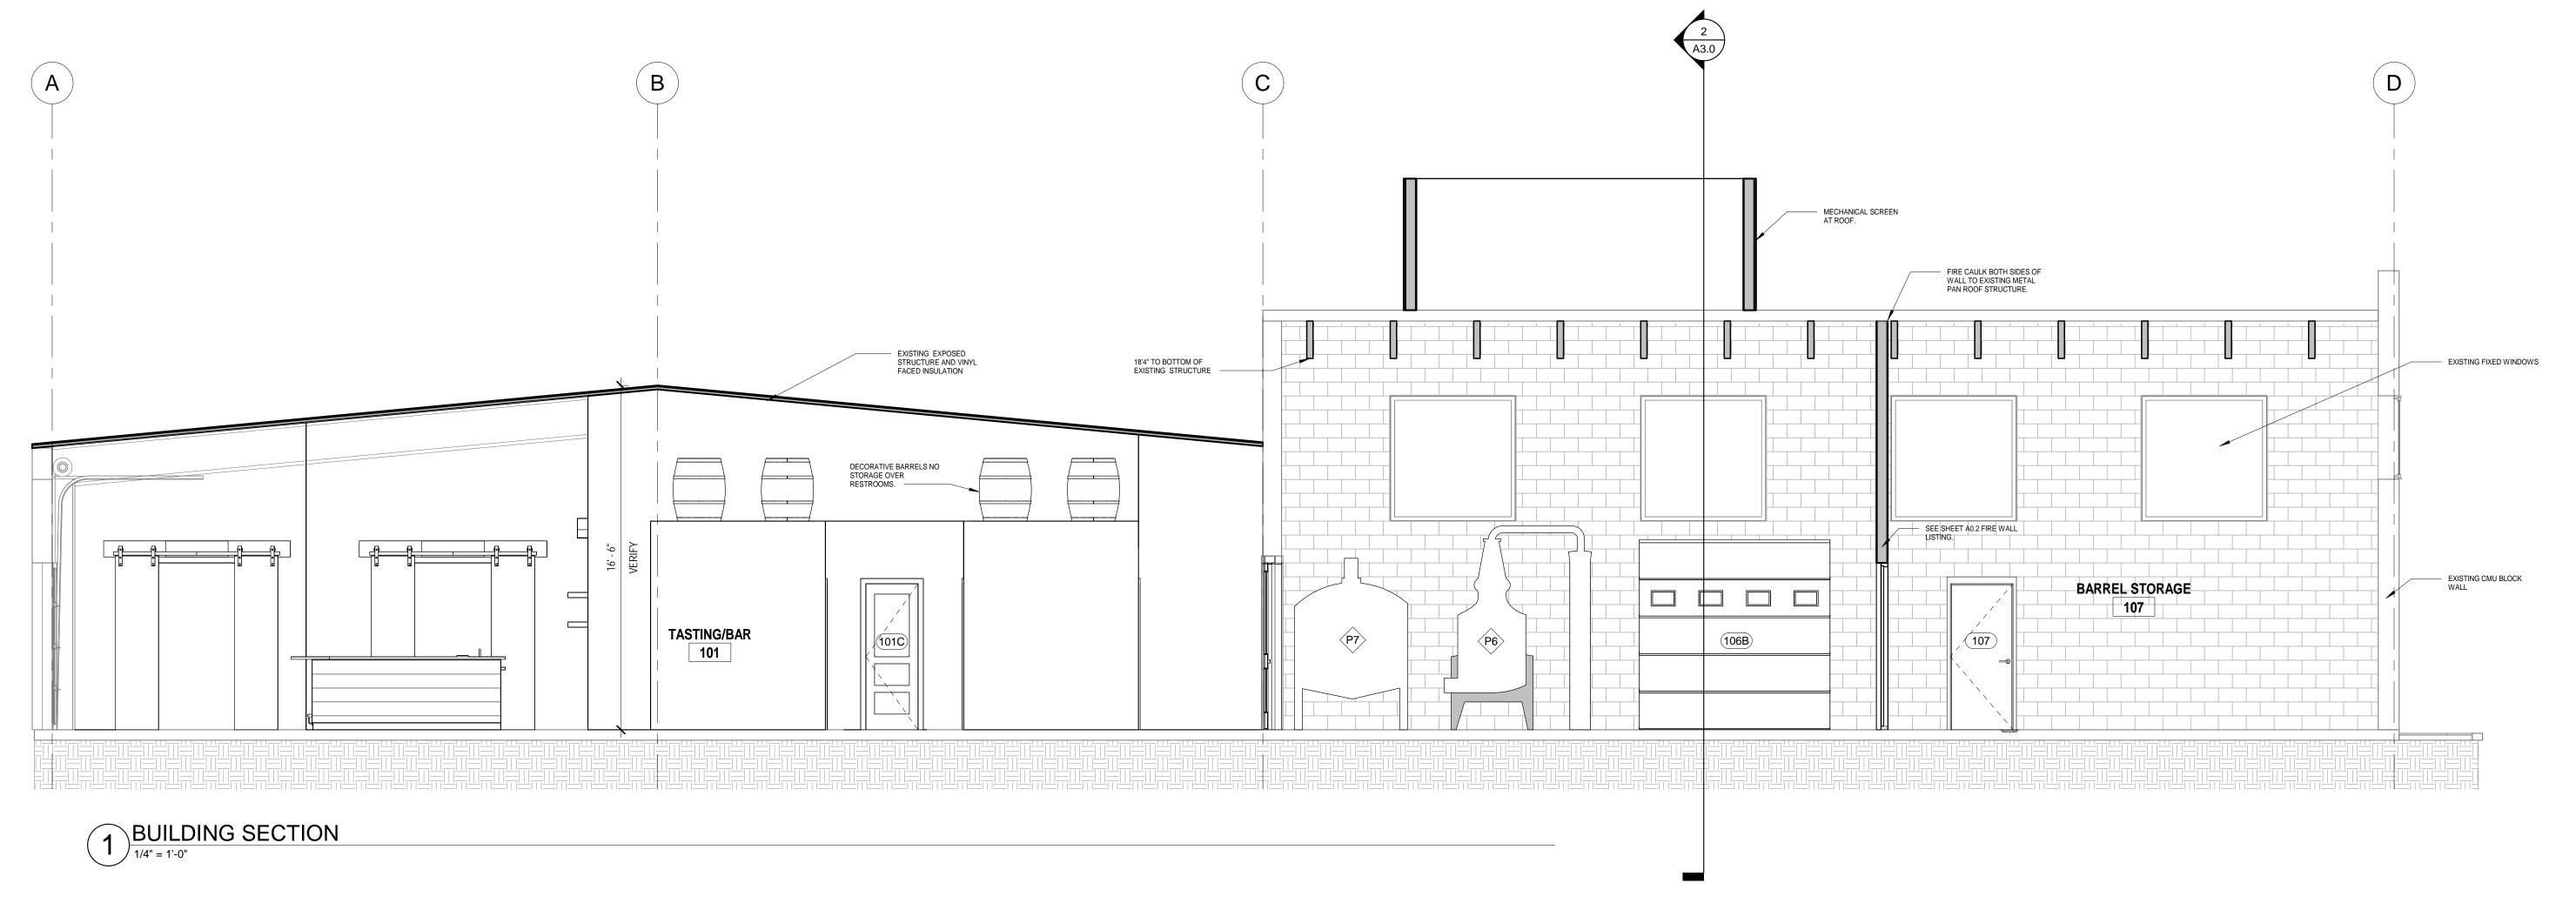

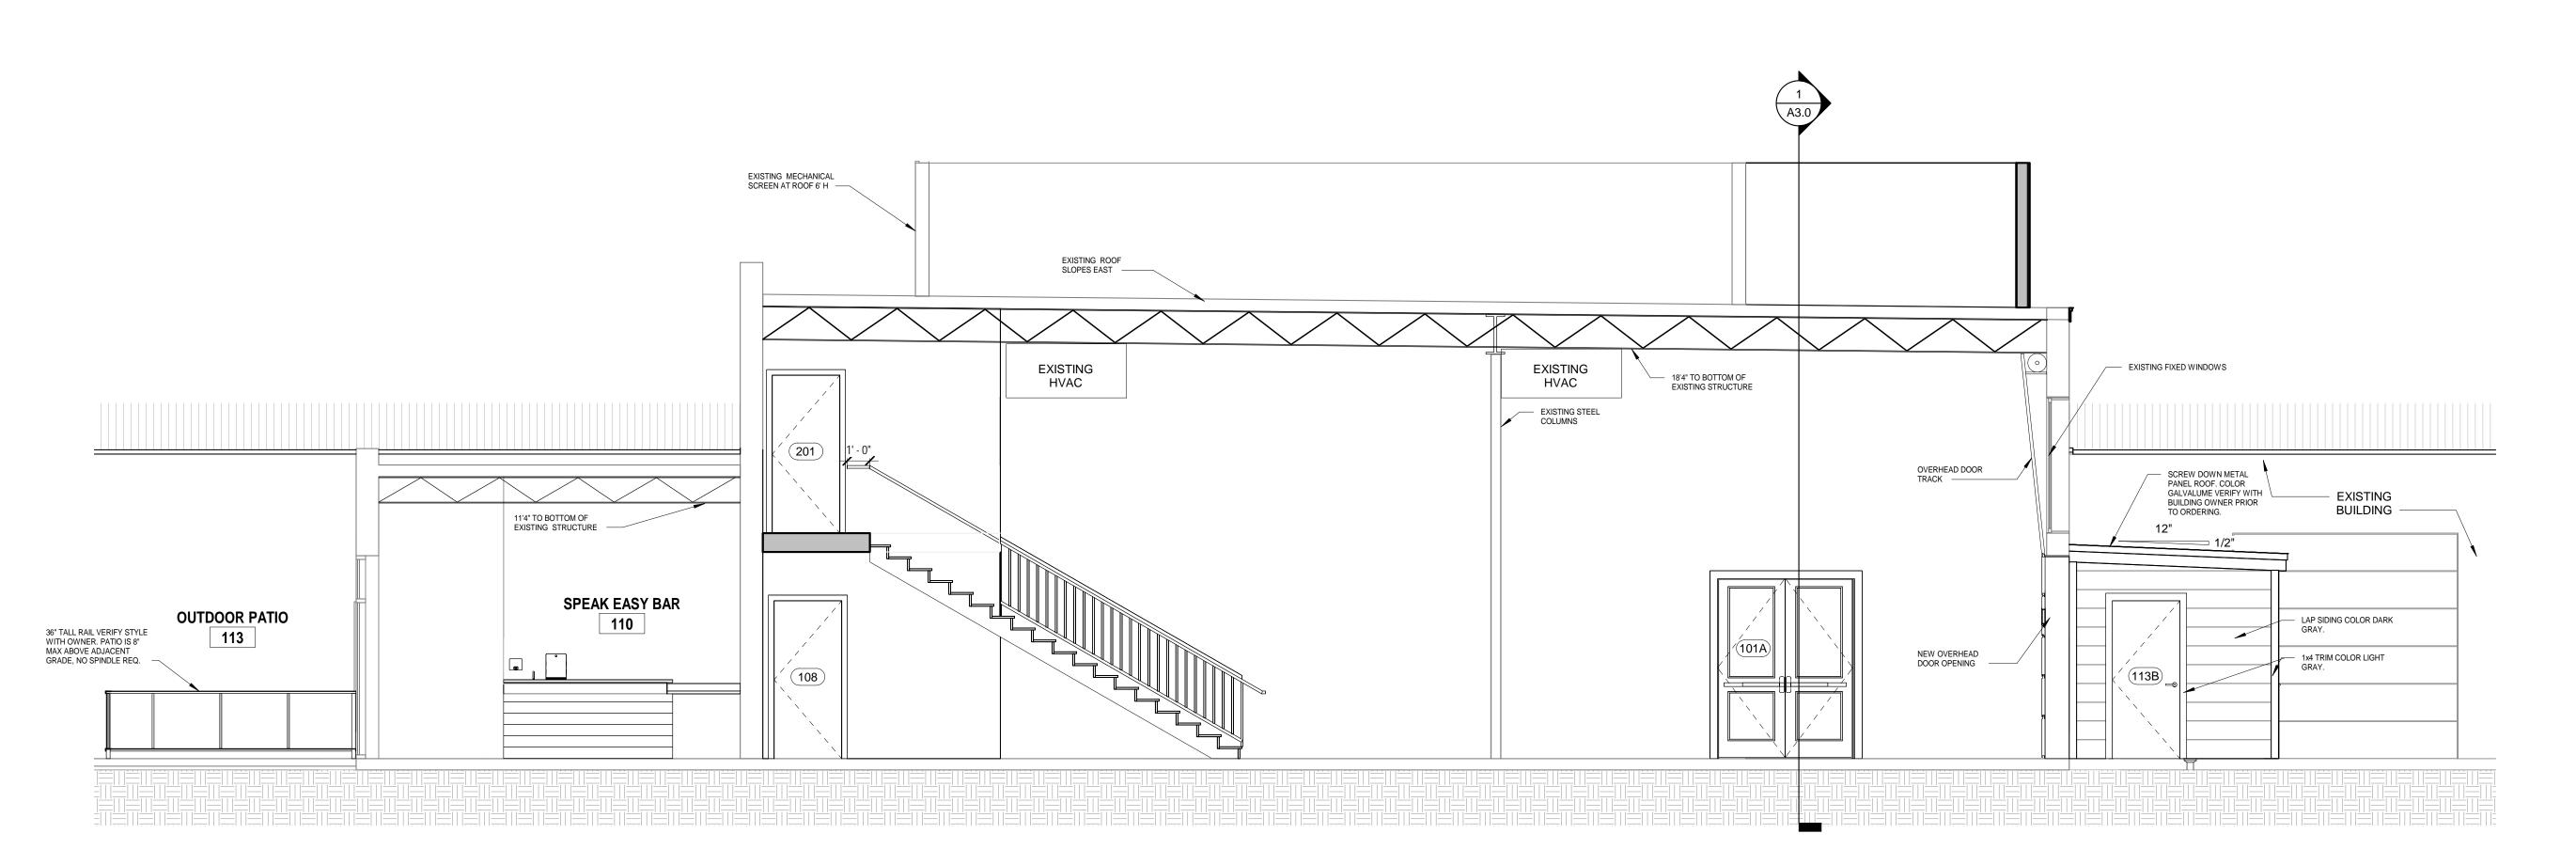


BUILDING SECTION

1/4" = 1'-0"



Approved January 11, 2022 © ASHER ARCHITECTS B.CORP. ALL RIGHTS RESERVED. This drawing is an instrument of service and is the sole property of Asher Architects. Use of this drawing is restricted to the original site for which it was prepared. Any reuse, reproduction, or publication of this drawing by any method in whole or in part without written consent of the architect is prohibited.

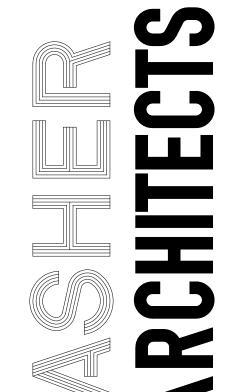


- a: 512 5th St. BERTHOUD CO. 80513 p: 970-532-9970
- w. AsherArch.com e: David@AsherArch.com




PROJECT INFORMATION: 21-C26 DOCUMENT DATE: 1/12/2022 2:49:37 PM DOCUMENT PHASE: CONSTRUCTION DOCUMENTS



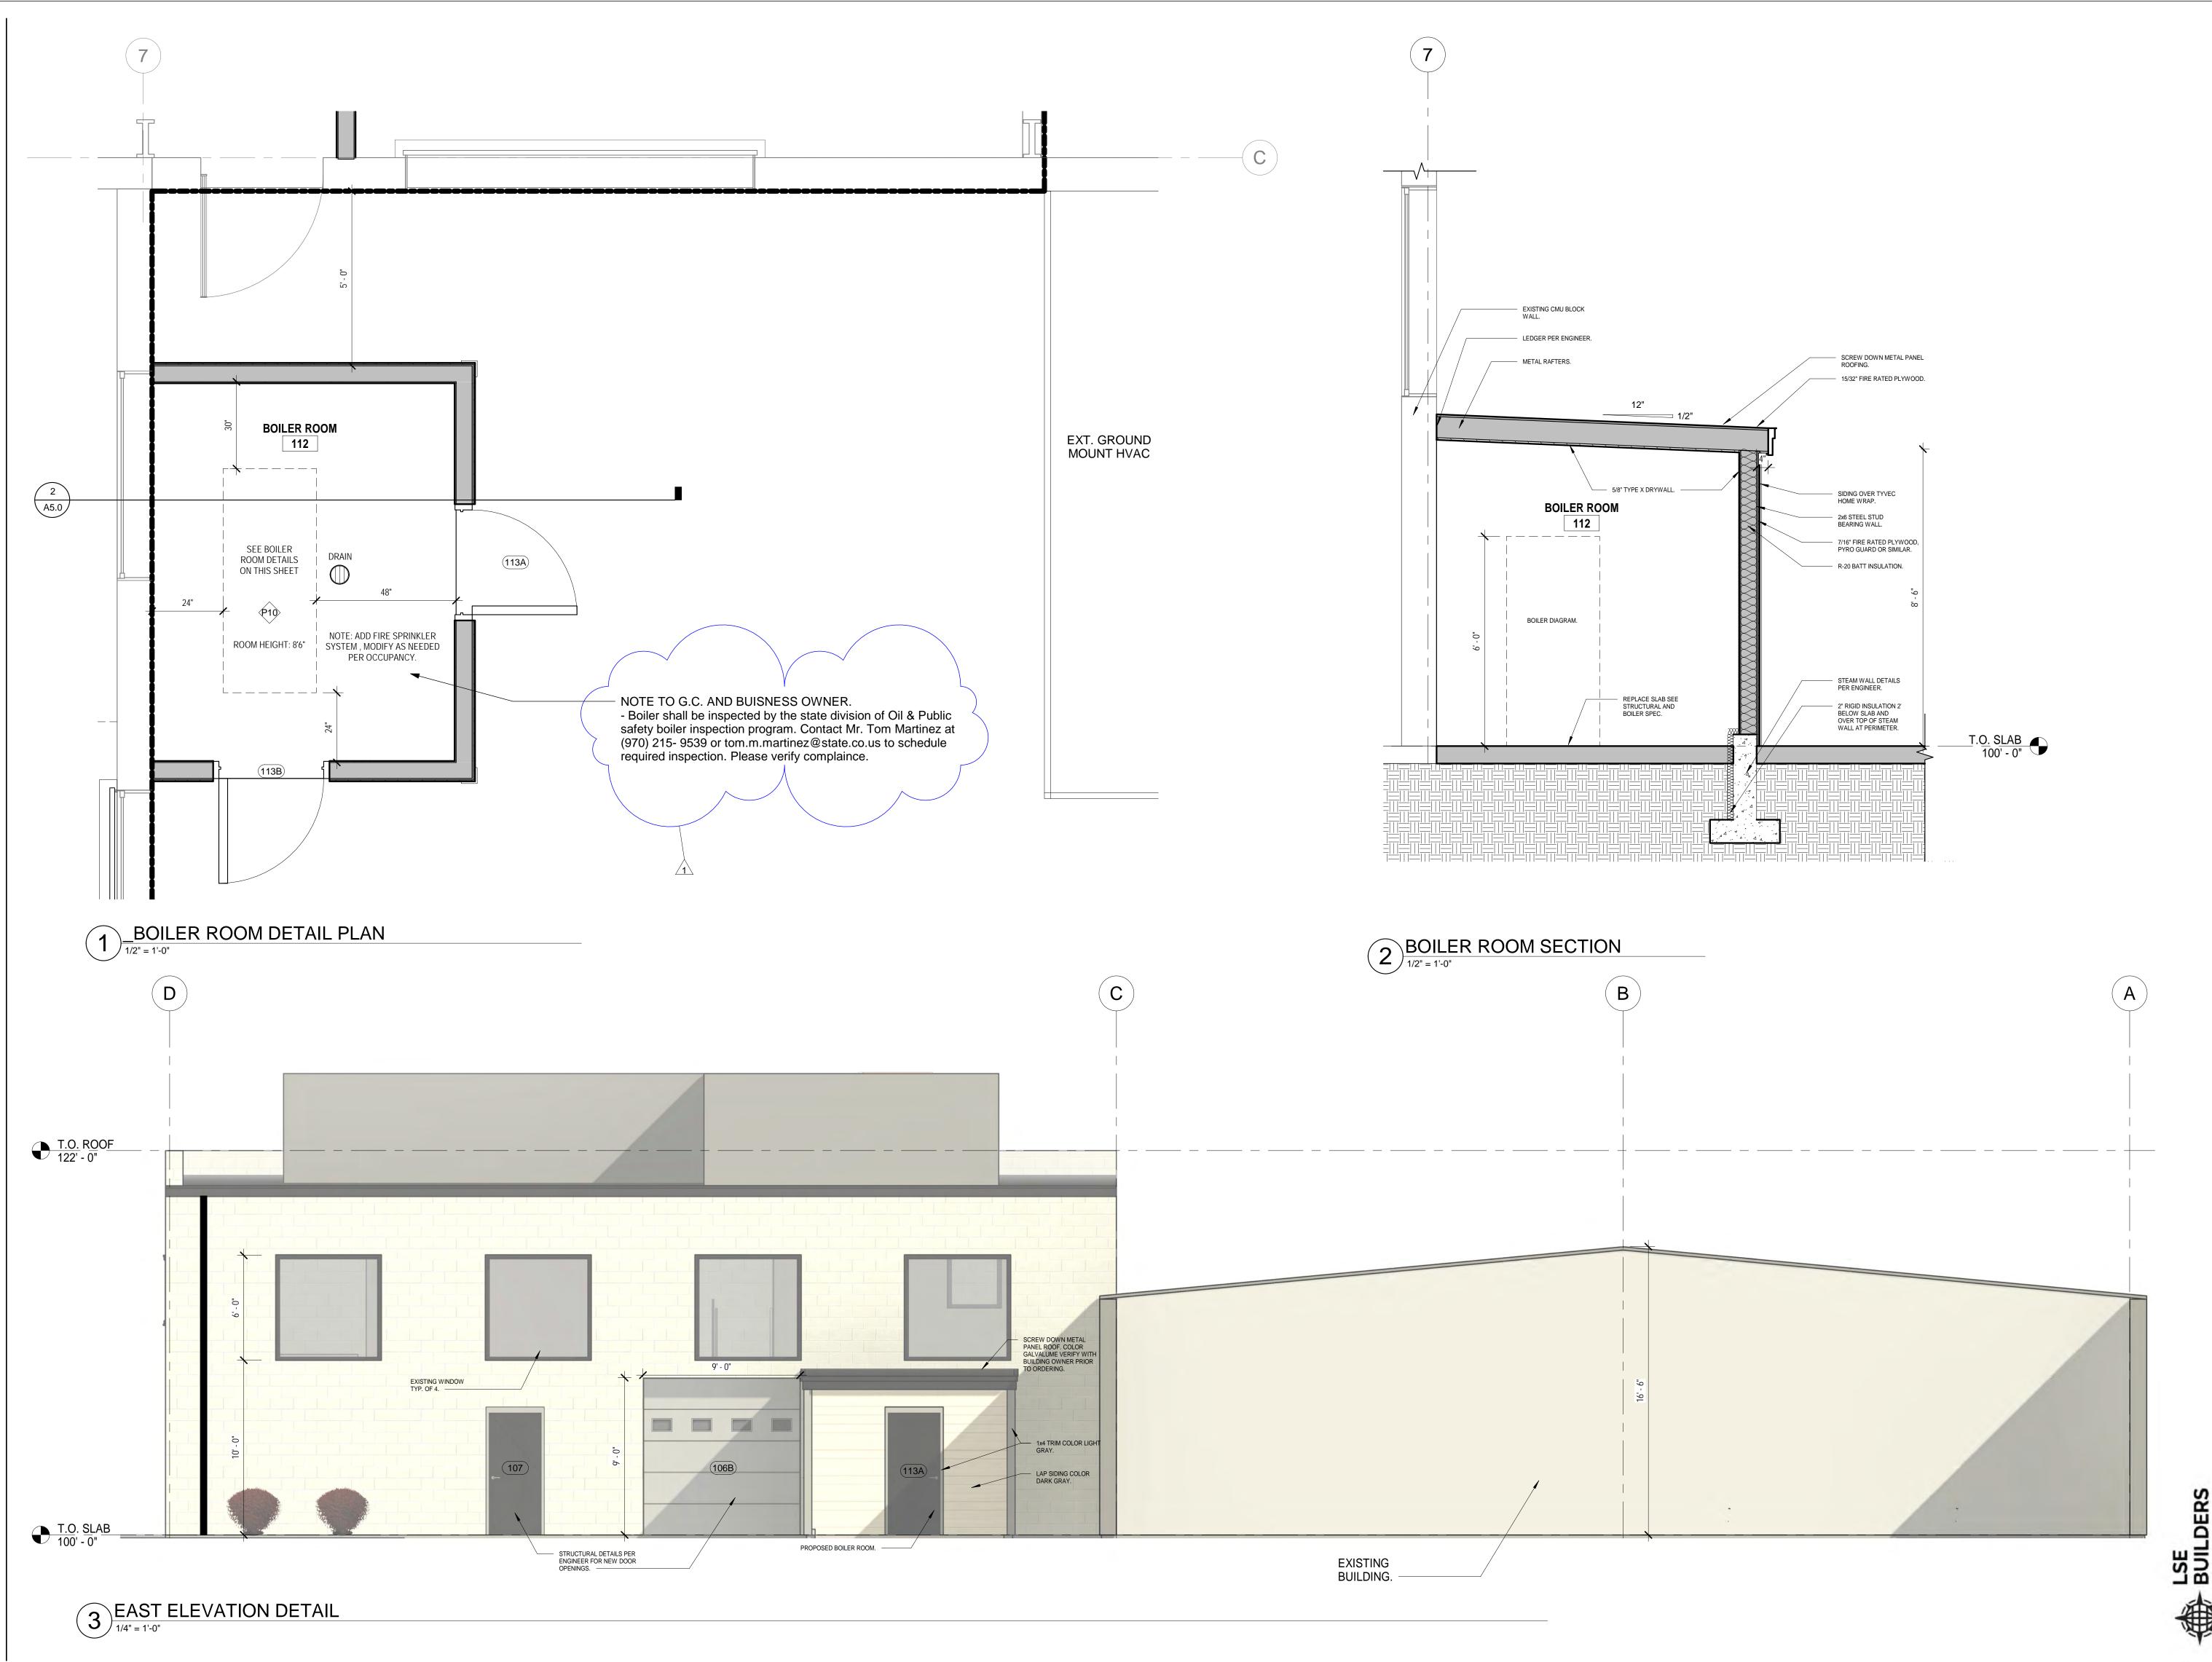



© ASHER ARCHITECTS B.CORP. ALL RIGHTS RESERVED. This drawing is an instrument of service and is the sole property of Asher Architects. Use of this drawing is restricted to the original site for which it was prepared. Any reuse, reproduction, or publication of this drawing by any method in whole or in part without written consent of the architect is prohibited.

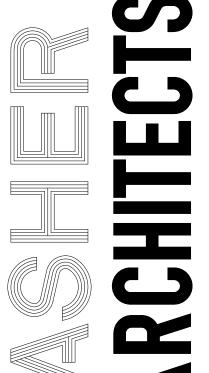


a: 512 5th St. BERTHOUD CO. 80513 p: 970-532-9970


w. AsherArch.com e: David@AsherArch.com




PROJECT INFORMATION: 21-C26 DOCUMENT DATE: 1/12/2022 2:49:46 PM DOCUMENT PHASE: CONSTRUCTION DOCUMENTS

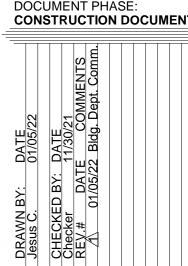

BOILER ROOM DETAILS

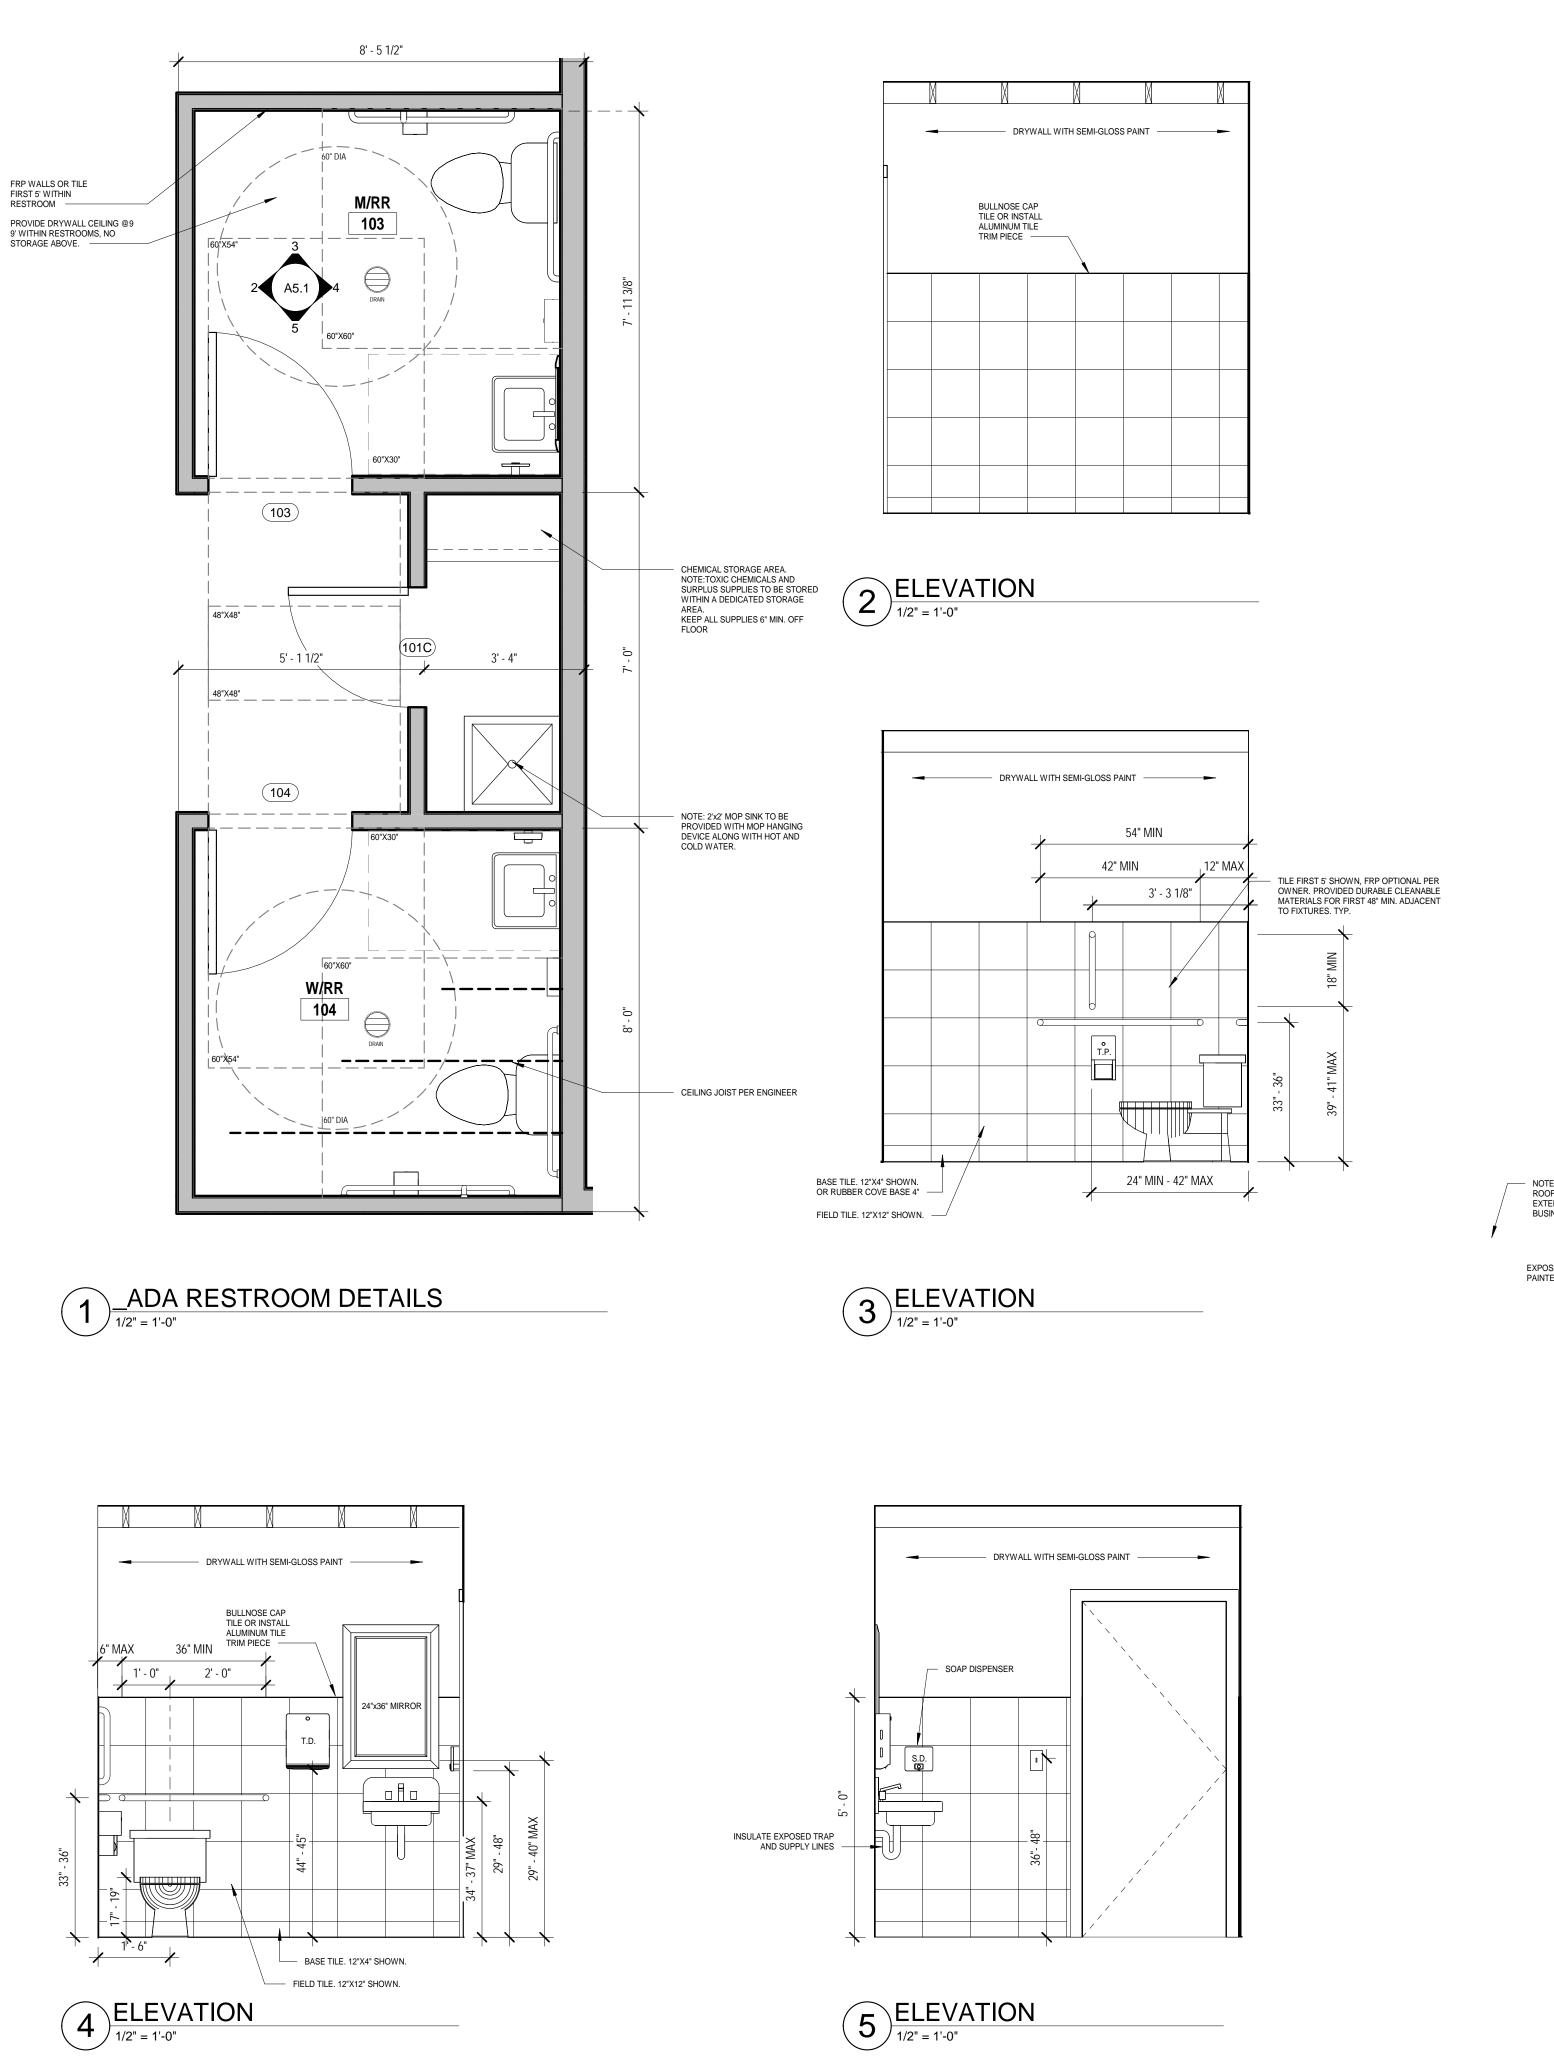


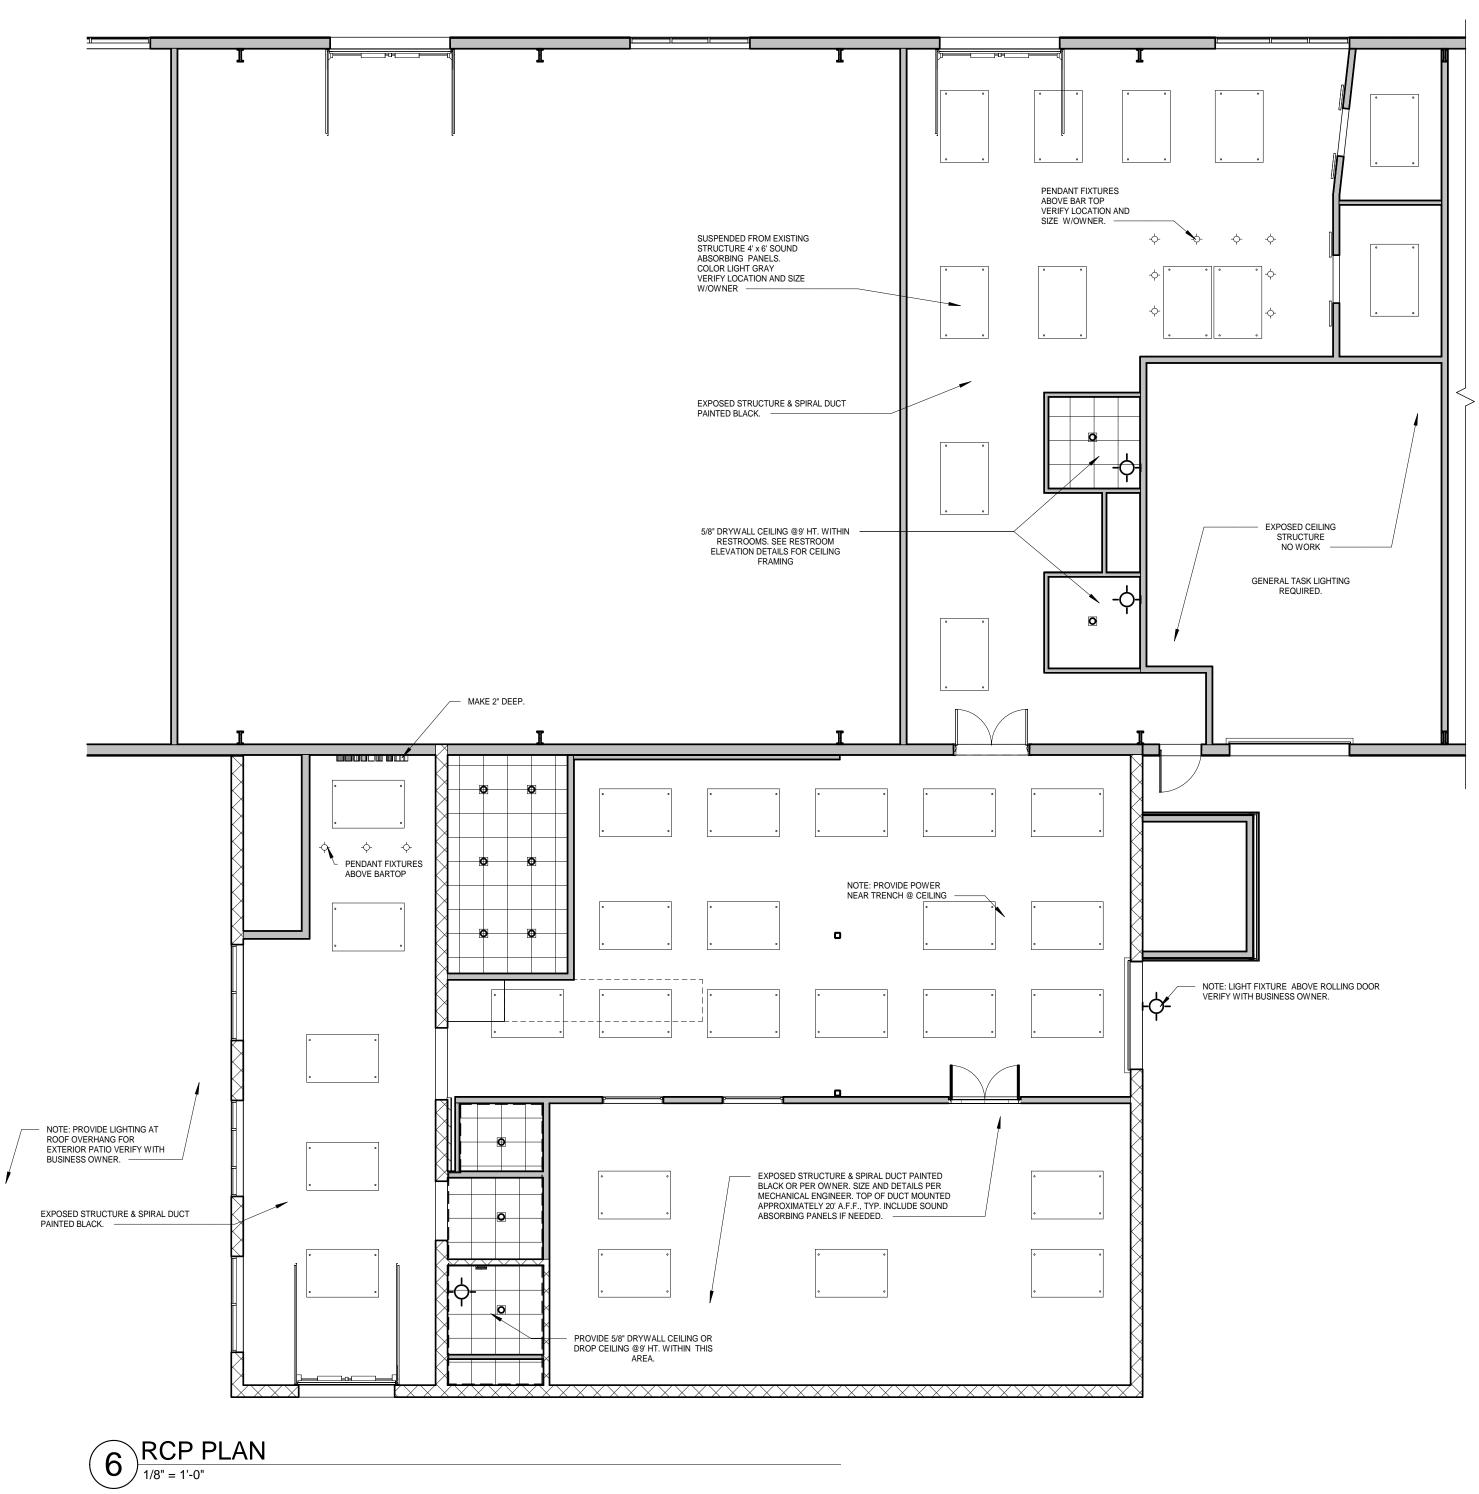

NOTE: LIGHTING LAYOUT IS GENERAL AND GENERIC IN NATURE. ELECTRICAL ENGINEERS DRAWINGS TAKE PRECEDENCE. CONFIRM EXACT FIXTURE TYPE AND STYLE WITH BUSINESS OWNER PRIOR TO PURCHASING. ELECTRICAL CONTRACTOR TO VERIFY ALL MOUNTING LOCATIONS AND HEIGHTS WITH BUSINESS OWNER.



Approved January 11, 2022 © ASHER ARCHITECTS B.CORP. ALL RIGHTS RESERVED. This drawing is an instrument of service and is the sole property of Asher Architects. Use of this drawing is restricted to the original site for which it was prepared. Any reuse, reproduction, or publication of this drawing by any method in whole or in part without written consent of the architect is prohibited.

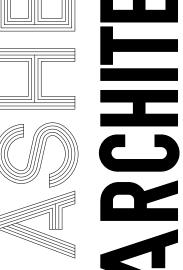

a: 512 5th St. BERTHOUD CO. 80513 p: 970-532-9970 w. AsherArch.com


e: David@AsherArch.com


FOR CONSTRUCTION

SKY SKY

COPPER

PROJECT INFORMATION: 21-C26 DOCUMENT DATE: 1/12/2022 2:49:49 PM DOCUMENT PHASE: CONSTRUCTION DOCUMENTS

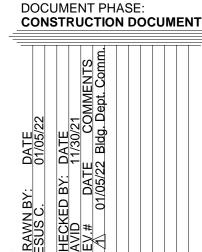

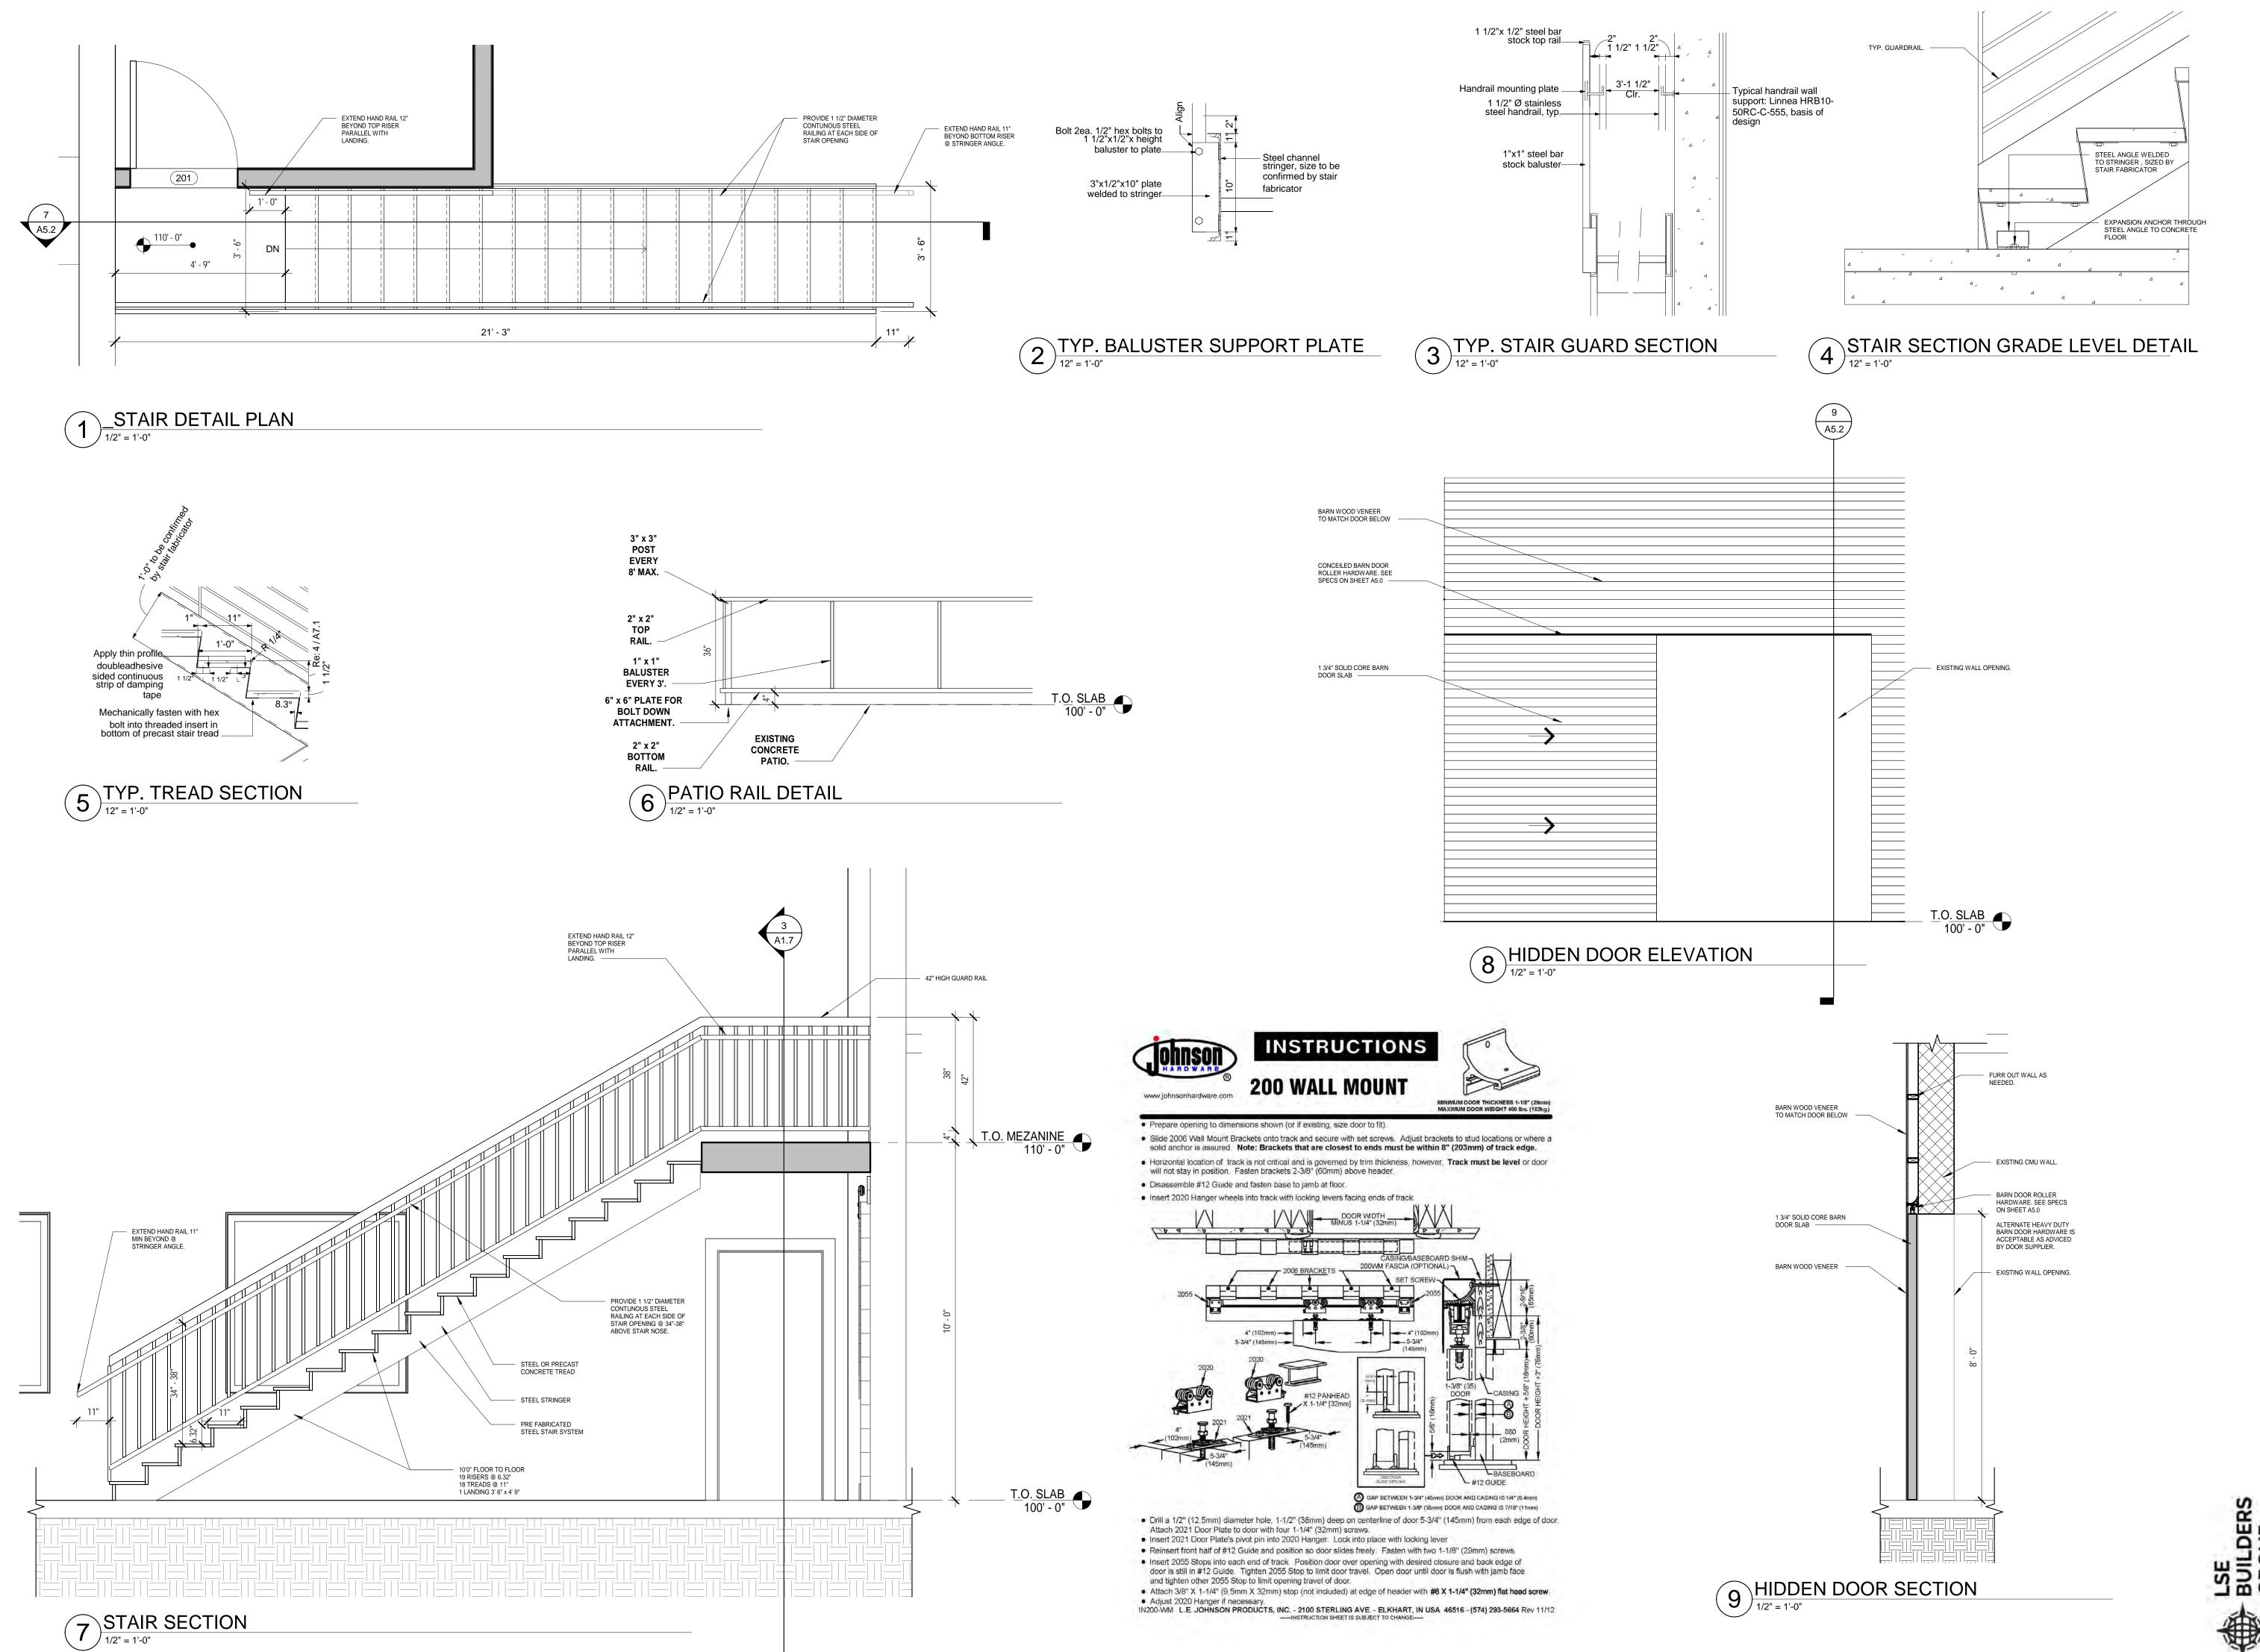



© ASHER ARCHITECTS B.CORP. ALL RIGHTS RESERVED. This drawing is an instrument of service and is the sole property of Asher Architects. Use of this drawing is restricted to the original site for which it was prepared. Any reuse, reproduction, or publication of this drawing by any method in whole or in part without written consent of the architect is prohibited.

reuse, reproduction, or publication of this drawing by any method in whole or in part without written consent of the architect is prohibited.

a: 512 5th St. BERTHOUD CO. 80513 p: 970-532-9970

w. AsherArch.com e: David@AsherArch.com



ESTILLERY

0 Emery Street


PROJECT INFORMATION:
21-C26

DOCUMENT DATE:
1/12/2022 2:49:51 PM

DOCUMENT PHASE:
CONSTRUCTION DOCUMENTS

BIRD DOCUMENTS

CONSTRUCTION DOCUMENTS

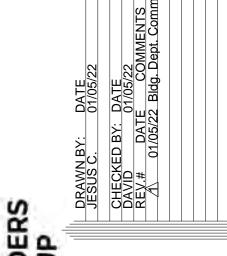

STAIR/ HIDDEN DOOR DETAILS/ SPEC SHEETS


A5.2






# 9'X16' SEPTIC TANK 10000 GAL.



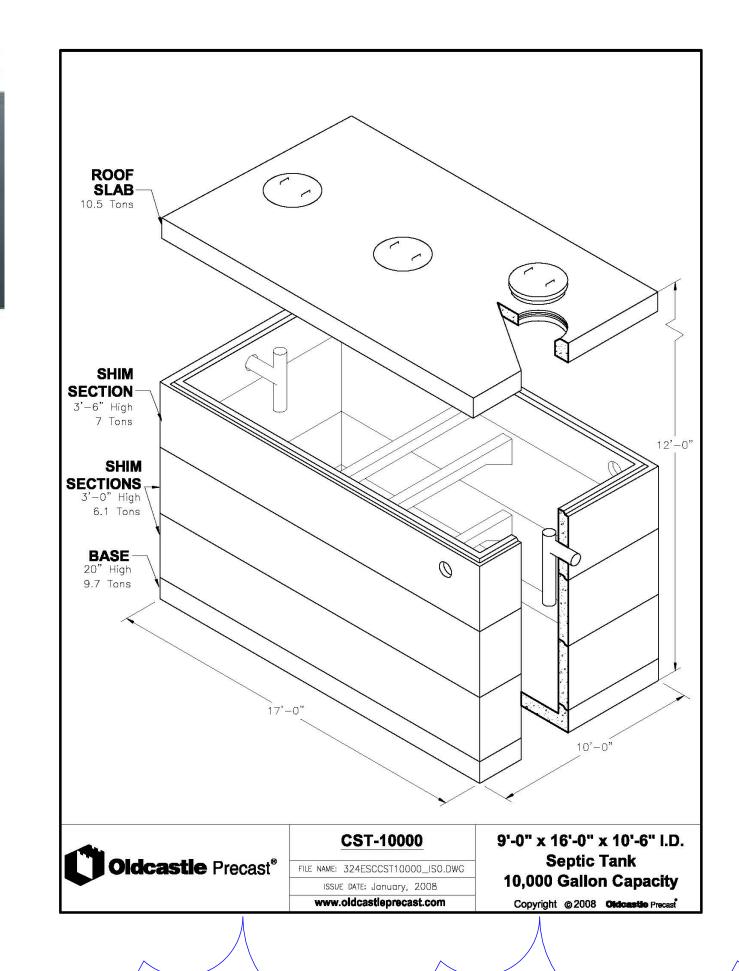

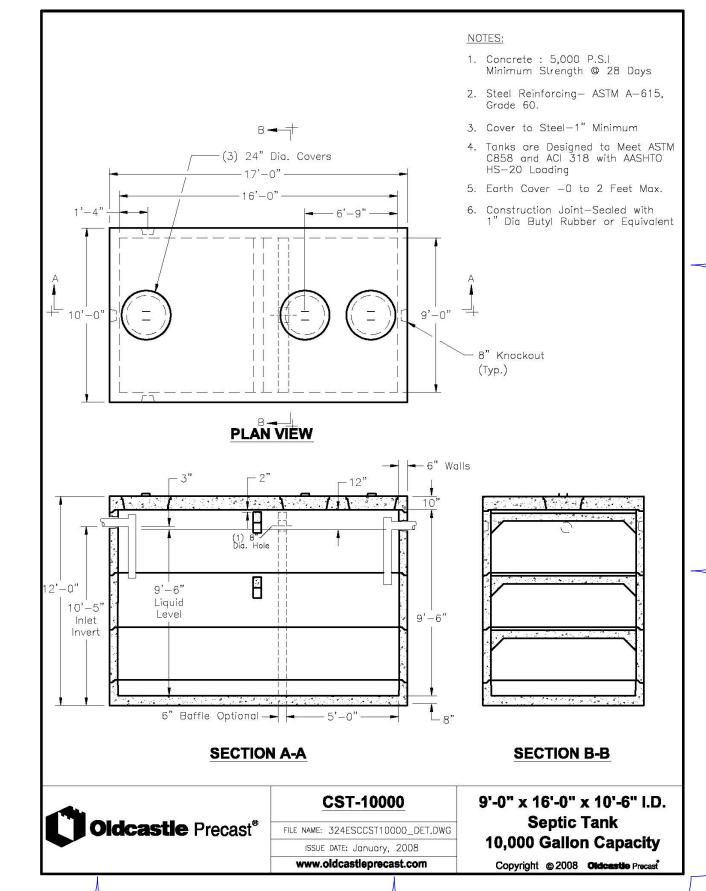

BUISNESS OWNER WILL VERIFY OR PROVIDE A CLASSIFIED FORKLIFT PER THE REQUIREMENTS BELOW NO FORKLIFT CHARGING OR STORAGE WILL OCCUR WITHIN THE H3 OCCUPANCY AREA. FORKLIFT STORAGE IS TO OOCCUR OUTDOORS AT LEAST 5' FROM THE STRUCTURE.

3 FORKLIFT SPECIFICATIONS
6" = 1'-0"

FOR CONSTRUCTION

a: 512 5th St.

p: 970-532-9970

w. AsherArch.com

BERTHOUD CO. 80513

e: David@AsherArch.com

© ASHER ARCHITECTS B.CORP

service and is the sole property of Asher Architects. Use of this

drawing is restricted to the original site for which it was prepared. Any

reuse, reproduction, or publication

of this drawing by any method in

whole or in part without written

ALL RIGHTS RESERVED. This drawing is an instrument of

SKY SKY COPPER

PROJECT INFORMATION: DOCUMENT DATE: 1/12/2022 2:49:52 PM

DETAILS/ SPEC

1 SEPTIK TANK SPEC SHEET

# SPILL CONTAINMENT WORKSTATIONS

Low-profile workstations protect floors from spills and leaks from 55-gallon drums.

- Configure drum handling and dispensing areas.
- Tough, high-density polyethylene construction.
- Resists chemicals, rust and corrosion.
- Withstands extreme temperatures -20° to 120°F.
- Non-skid, easy-to-clean removable grates.
- Ramp 1,000 lb. capacity. Easy loading/unloading.
- Meets EPA, SPCC and NPDES regulations.

MODEL	DESCRIPTION	DIMENSIONS	SUMP	WT.	PRICE	RICE EACH		
NO.	DESCRIPTION	LxWxH	(LBS.)	CAP.	(LBS.)	1	3+	
H-4865	1 Drum	25 x 25 x 6"	2,000	12 Gal.	16	\$110	\$105	
■H-4036	2 Drum	49 x 25 x 6"	2,500	24 Gal.	33	160	150	
■H-4037	4 Drum	49 x 49 x 6°	6,000	49 Gal.	65	265	255	
H-4038	Work Ramp	33 x 48 x 6"	1,000	N/A	42	205	195	
H-4039	Connectors	Set of 2	N/A	N/A	2	15	14	





Connectors – Create custom configurations. Securely connect two or more

# **SPILL DIKES**

Blocks off machine spills and leaky IBC tanks. Confines oil, water and chemicals.

- Tacky, flexible polyurethane seals tight to floors.
- Nonabsorbent, washable and reusable.
- High Profile 41/2" height for high-volume spills. Interlocking ends for longer runs.
- Low Profile 2¼" height. Cut to desired length.



MODEL	DECCRIPTION	SIZE	WT.	PRICE	ADD TO		
NO.	DESCRIPTION	LxWxH	(LBS.)	1	2+	(	CART
H-8678	High Profile	5' x 4" x 4 1/2"	16	\$525	\$500	1	ADD
H-8679	Low Profile	10' x 4" x 2 1/4"	30	650	625	1	ADI